



Historic Preservation Commission

August 22, 2024

3:00PM

Village Hall, 235 Hickory Street, Pewaukee, WI 53072

To view the meeting live:

<https://www.youtube.com/live/oNWT3Qbm-7k?si=rQYdj5pgkpEIXbVb>

1. Call to Order and Roll Call
2. Citizen Comments. – *This is an opportunity for citizens to share their opinions with Board Members on any topic they choose. However, due to Wisconsin Open Meeting laws, the Board is not able to answer questions or respond to your comments. All comments should be directed to the Board. Comments are limited to 3 minutes per speaker. Speakers are asked to use the podium and state their name and address.*
3. Presentation –
 - a. Presentation, Discussion and Consultation by Pastor Florin for the installation/design of an interior elevator located at Agape Community Church 449 W Wisconsin Ave PWV 0893013002.
4. Adjournment.

Note: Notice is hereby given that a quorum of a Village Committee and/or Commission may be present at the Village Board meeting, and if so, this meeting shall be considered an informational meeting of that Committee or Commission and no formal action of that Committee or Commission shall occur. Upon reasonable notice, efforts will be made to accommodate the needs of disabled individuals through appropriate aids and services. To request such assistance, contact the Village Clerk at 262-691-5660.

Posted August 15, 2024



To: Village of Pewaukee Historical Preservation Commission

From: Matt Heiser
Village Administrator

Date: August 14, 2024

Re: August 22 Agenda Item 3(a):
Presentation, Discussion and Consultation by Pastor Florin for the installation/design of
an interior elevator located at Agape Community Church 449 W Wisconsin Ave PWV
0893013002.

BACKGROUND

Agape Church took ownership of the current building after it was clear the community valued its historic nature. At that time Agape Church staff had presented the concept of installing a small mechanical lift to assist patrons with mobility issues.

The time has come for the lift to be designed and constructed. Pastor Florin will make a small presentation to describe the project.

ACTION REQUESTED

Agape Church is not seeking any formal action at this time. They are requesting input from/consultation with the members of the Commission regarding the installation of the lift.

ANALYSIS


None.

Attachments:


1. Submittal 1 Designs for the Lift
2. Submittal 2 Designs for the Lift

TYPICAL PLAN

PLEASE NOTE:
OVERALL HOISTWAY LENGTH AND WIDTH DIMENSIONS ARE FROM DRYWALL TO DRYWALL (WHERE APPLICABLE)

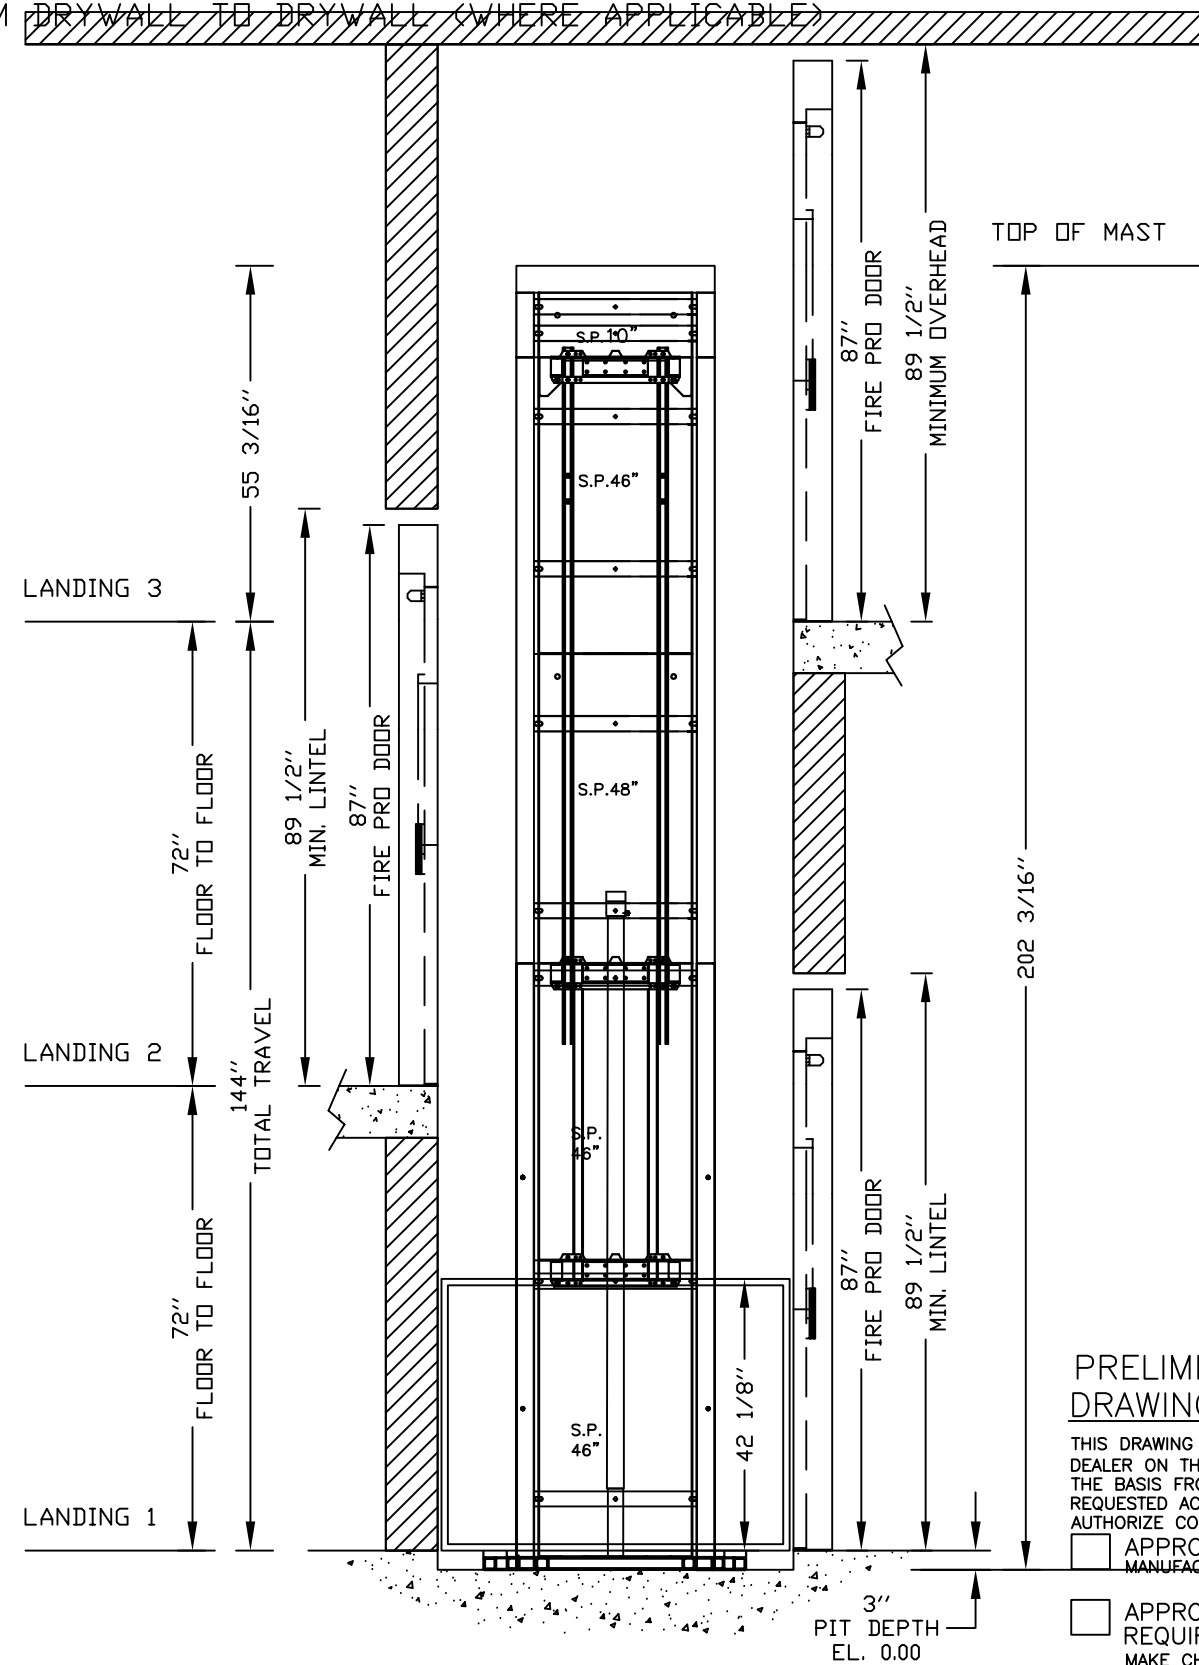

ELEVATION B-B

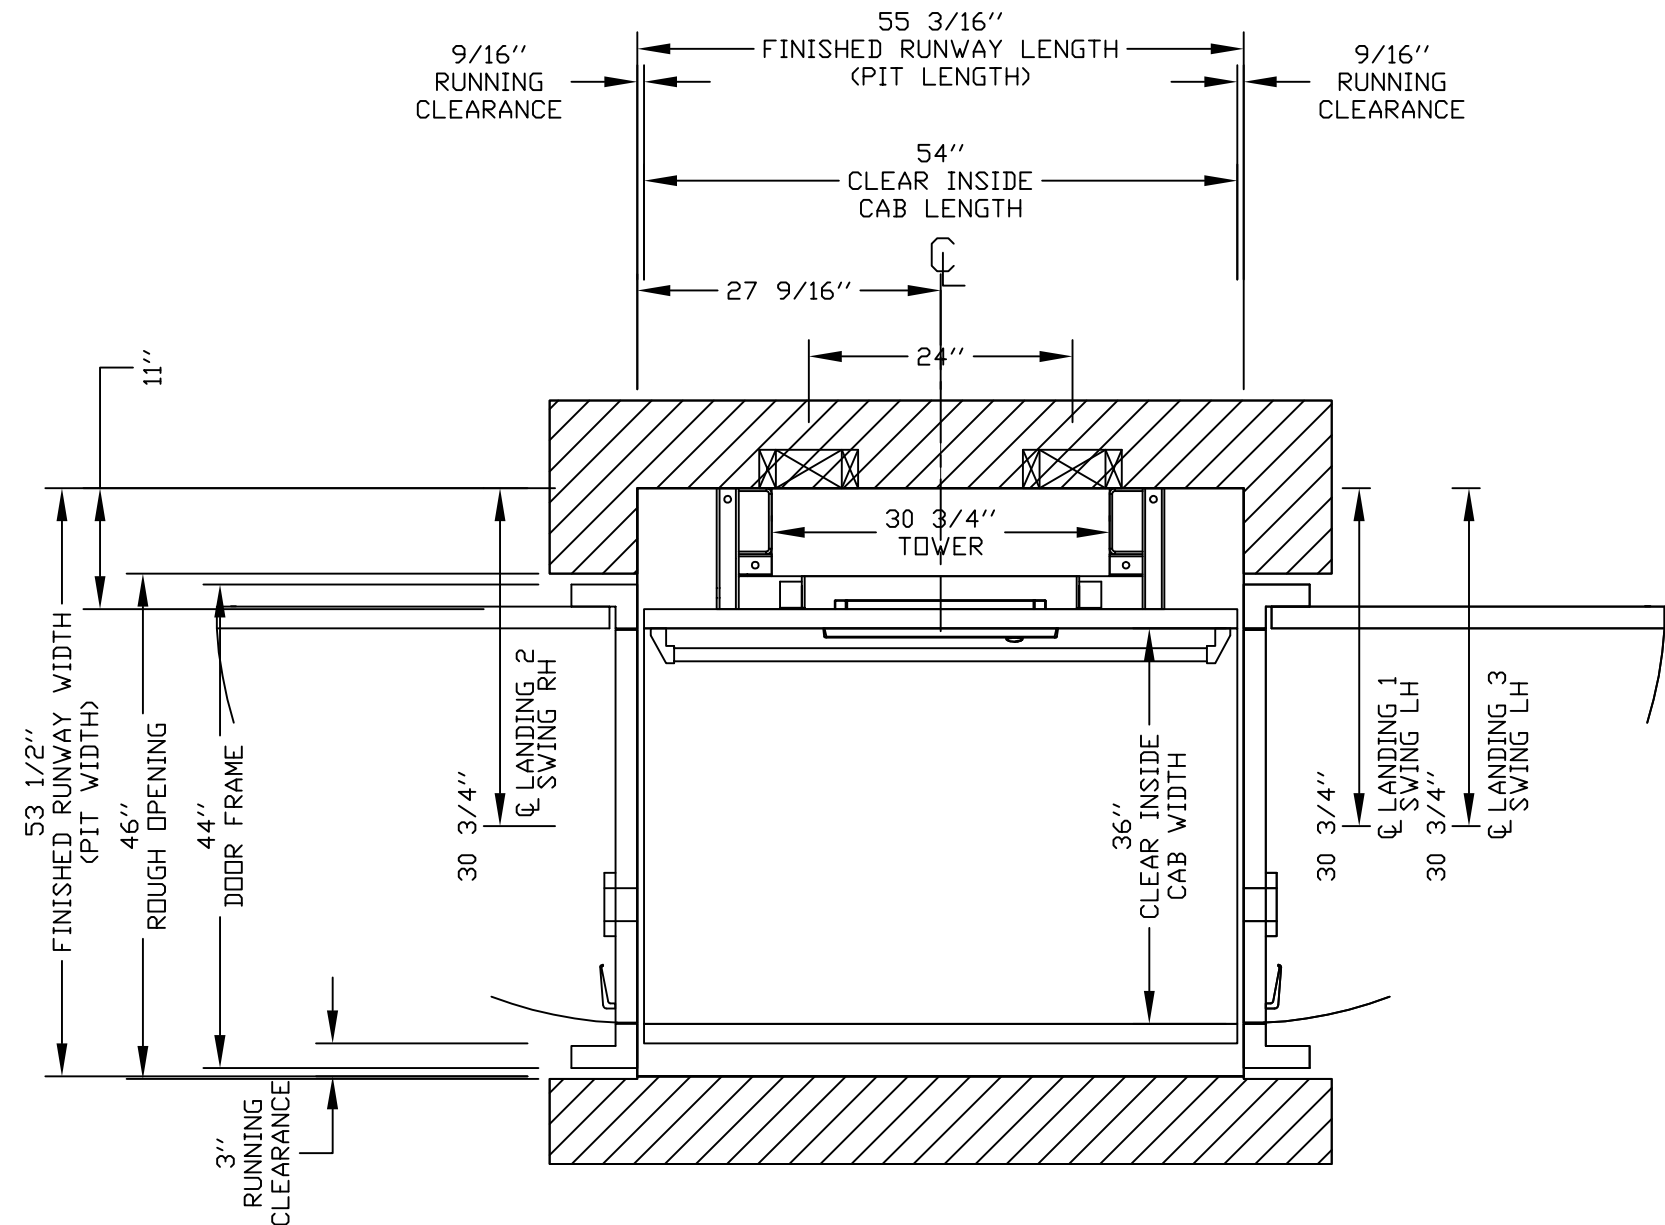

PRELIMINARY DRAWING ONLY DRAWING APPROVAL:

THIS DRAWING REFLECTS OUR INTERPRETATION OF THE INFORMATION PROVIDED BY THE DEALER ON THE ORDER FORM. THIS INFORMATION IS THE DEALER'S RESPONSIBILITY, AND IS THE BASIS FROM WHICH THIS LIFT IS DESIGNED AND MANUFACTURED. PLEASE INDICATE THE REQUESTED ACTION BY CHECKING ONE OF THE FOLLOWING BOXES AND SIGNING BELOW TO AUTHORIZE COMPLETION OF THIS ORDER.


- APPROVED WITH NO EXCEPTIONS
MANUFACTURE PRODUCT AS PER DRAWING
- APPROVED WITH EXCEPTIONS, NO REAPPROVAL REQUIRED
MAKE CHANGES AS NOTED, NO REAPPROVAL DRAWING REQUIRED
- CHANGE AS NOTED, REAPPROVAL REQUIRED
MAKE CHANGES AS NOTED, SEND CORRECTED DRAWING FOR REAPPROVAL BEFORE MANUFACTURE

CHANGES REQUEST:

1. _____
2. _____
3. _____
4. _____


SIGNATURE: _____ DATE: _____

CAUTION: ONCE THE DRAWING IS APPROVED, JOB CANCELLATION FEES WILL APPLY

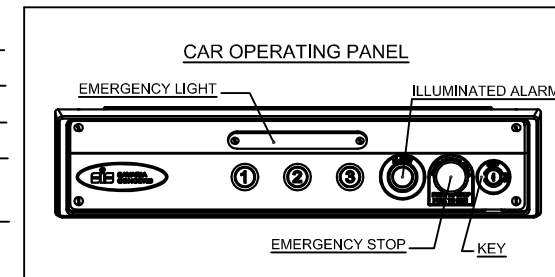

OFFICE USE ONLY:	
CONFIGURATION VERSION STAMP:	0.0
MODULE VERSION STAMP:	B-S-86.3

Part No.	V-1504
Variant No.	1087963

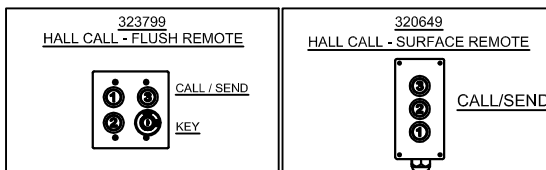

GENERAL ARRANGEMENT
ENCLOSED VERTICAL WHEELCHAIR PLATFORM LIFT

CUSTOMER:	ACCESS ELEVATOR INC. (WI)
PROJECT:	AGAPE COMMUNITY CHURCH
ADDRESS:	449 W. WISCONSIN AVENUE, PEWAUKEE WISCONSIN, USA, 53072

DATE:	03-14-23
REVISION DATE:	03-14-23
COMPLETED BY:	JRW/TA/AR/AN/CS

savaria.

JOB No. P00000 SHEET No. 1 OF 6

PROVISIONS BY OTHERS

GENERAL

HOISTWAY - THE HOISTWAY MUST BE DESIGNED AND BUILT IN ACCORDANCE WITH "SAFETY STANDARD FOR PLATFORM LIFTS AND STAIRWAY CHAIRLIFTS" OR "SAFETY CODE FOR ELEVATORS AND ESCALATORS" AND ALL STATE AND LOCAL CODES.

PLUMB RUNWAY - DUE TO CLOSE RUNNING CLEARANCES OWNER/AGENT MUST ENSURE THAT HOISTWAY AND PIT (WHERE PROVIDED) ARE LEVEL, PLUMB (-/+ 1/8" (3 mm)) AND SQUARE AND ARE IN ACCORDANCE WITH THE DIMENSIONS ON THESE DRAWINGS.

MINIMUM OVERHEAD CLEARANCE- OWNER/AGENT MUST ENSURE MINIMUM OVERHEAD CLEARANCE IS IN COMPLIANCE WITH CODES.

CONSTRUCTION SITE- OWNER/AGENT TO PROVIDE ALL MASONRY, CARPENTRY AND DRYWALL WORK AS REQUIRED AND SHALL PATCH AND MAKE GOOD (INCLUDING FINISH PAINTING) ALL AREAS WHERE WALLS/FLOORS MAY REQUIRE TO BE CUT, DRILLED OR ALTERED IN ANY WAY TO PERMIT THE PROPER INSTALLATION OF THE LIFT.


DIMENSIONS- CONTRACTOR/CUSTOMER TO VERIFY ALL DIMENSIONS AND REPORT ANY DISCREPANCIES TO OUR OFFICE IMMEDIATELY.

STRUCTURAL

FLOOR/SUPPORT WALL LOADS- CONTRACTOR TO ASSURE THAT BUILDING AND SHAFT WILL SAFELY SUPPORT ALL LOADS IMPOSED BY THE LIFT EQUIPMENT. REFER TO THE LOAD DIAGRAM ON THIS DRAWING.

MAST TO BE SECURELY FASTENED- WHERE REQUIRED THE MAST MUST BE SECURELY FASTENED TO THE STRUCTURAL SUPPORT WALL. REFER TO WALL / FLOOR SUPPORT LOAD DIAGRAM AND WALL LAG DIMENSIONS ON THIS DRAWING.

WHERE DOORS ARE REQUIRED- SUITABLE LINTELS MUST BE PROVIDED BY OWNER/AGENT. DOOR FRAMES ARE NOT DESIGNED TO SUPPORT OVERHEAD WALL LOADS.

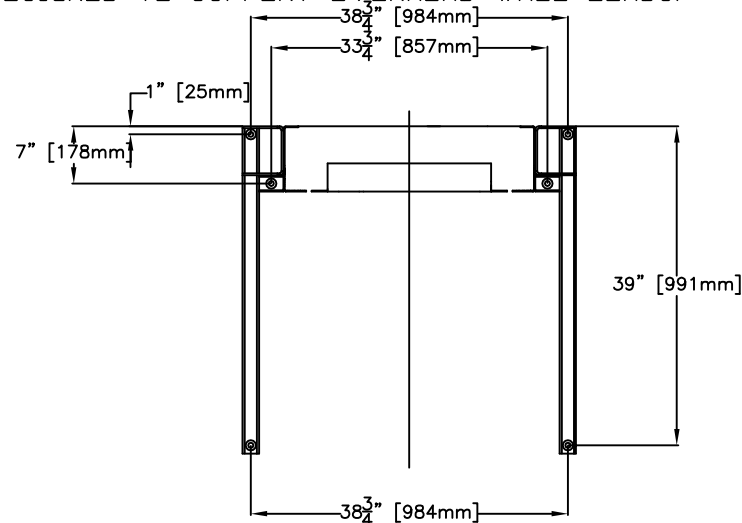

LOADS CALCULATED ON BASED ON ANCHOR POINTS EVERY 48" EVERY TOWER SECTION NEEDS TO BE ANCHORED. IF SPACING IS INCREASED, LOADS PER BRACKETS WILL INCREASE ACCORDINGLY.

ELECTRICAL

GENERAL- ELECTRICAL EQUIPMENT AND WIRING TO COMPLY WITH SECTION 38 OF CSA C22.1 (CANADA) OR SECTION 620 OF NEC ANSI/NFPA 70 (USA).

POWER SUPPLY- 120VAC, 20A, 60HZ, 1PH CIRCUIT THROUGH A FUSE DISCONNECT WITH AUXILIARY CONTACT ON MAIN POWER SUPPLY. PROVIDE TWO 18 AWG CONDUCTORS BETWEEN CONTACT AND CONTROLLER.

LIGHTING- LIGHTING OF 100 LX MIN. AT PLATFORM AND LANDINGS. LIGHTING WITH SWITCH AND ELECTRICAL GFCI OUTLET IN HOISTWAY PIT.

PHONE- IF A TELEPHONE CIRCUIT IS REQUIRED, JACK OR PHONE ARE PROVIDED ON THE CAR. A DEDICATED ANALOG PHONE LINE (NO VOIP) IS REQUIRED TO BE PROVIDED BY OTHERS TO THE CONTROLLER FOR VOIP, PLEASE CONTACT SAVARIA.

SAVARIA LINK REMOTE MONITORING - NOT APPLICABLE
Not required


ENTRANCES

UPPER LANDING GATES- WHERE REQUIRED, SMOOTH SOLID BARRIERS ARE TO BE SUPPLIED AND INSTALLED ON BOTH SIDES OF ENTRANCE AT UPPER LEVEL AND MUST BE A MINIMUM OF 42" (1067 mm) HIGH. ENTRANCE ASSEMBLY MUST BE IN PLACE PRIOR TO THIS PROVISION.


FASCIA PANEL BELOW UPPER LEVEL ENTRANCE- WHERE REQUIRED, FASCIA PANEL MUST BE FASTENED TO A SOLID WALL AND BE PERPENDICULAR TO THE FLOOR AND WALLS. HOISTWAY FASCIA IS NOT SELF-SUPPORTING FOR LONG, CONTINUOUS RUNS VOID OF ENTRANCES. ADEQUATE SUPPORT FOR THE FASCIA MUST BE PROVIDED.

ENTRANCE ASSEMBLIES- ENTRANCE ASSEMBLIES MUST BE ADJUSTED TO ALIGN WITH PLATFORM AND INTERLOCK EQUIPMENT. OTHERS TO ALLOW AN ADEQUATE ROUGH OPENING.

RETURN WALLS- RETURN WALLS AT ENTRANCES MUST BE BUILT-IN BY OTHERS AFTER ENTRANCE ASSEMBLIES ARE IN PLACE. ENTRANCE ASSEMBLY MUST BE SECURELY FASTENED TO WALLS.

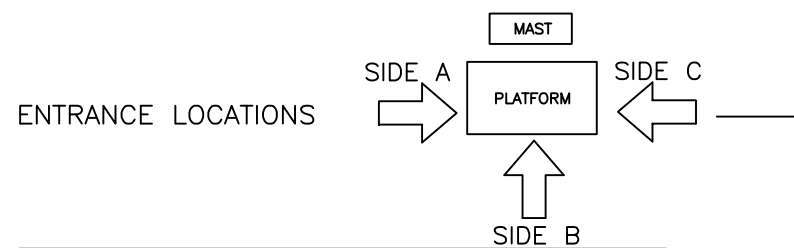

WALL / FLOOR SUPPORT LOAD DIAGRAM

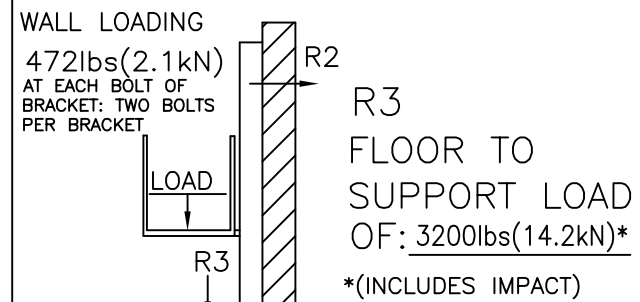

472lbs(2.1kN) IS DEAD LOAD PLUS LIVE LOAD AT ALLOWABLE STRESS DESIGN LEVELS. STRUCTURAL ENGINEER OF RECORD MUST CALCULATE THE SITE-SPECIFIC SEISMIC LOAD AND WIND LOAD.

DATA SHEET

ENCLOSED VERTICAL WHEELCHAIR PLATFORM LIFT

GENERAL

CLASSIFICATION: Enclosed Vertical Wheelchair Platform Lift
APPLIED CODE: ASME A18.1-2017 Section 2 Pub
SPECIAL NOTE:

MODEL: V-1504 Shaftway or Decklift
CAPACITY: 750 lbs (341 kg)
NOMINAL SPEED: 20 fpm (0.102 m/s)
TRAVEL: 144" (3658 mm)

PIT DEPTH: 3" (76 mm)
PLATFORM SIZE: 36" X 54" (914 mm X 1372 mm)
POWER SUPPLY: 120V, 20A, 60Hz, SINGLE PHASE
BATTERY BACK UP: down direction only

JACK UNIT

STROKE: 84" (2134 mm)
PLUNGER O/D: 2.0" (51 mm)
CYL. O/D: 2.625" (67 mm)
CYL. I/D: 2.25" (57 mm)

CONTROLLER

MODEL: V-1504
TYPE: CPFS
QPS #: LR1390-7R2
AMP: 100 A
MFR.: SAVARIA

DOORS / GATES / CALL STATIONS

DOOR TYPE
ENTRANCE SIDE
DOOR SWING
DOOR INSERT
LOCK TYPE
AUTO DOOR OPENER
CUSTOM DOOR WIDTH
CUSTOM DOOR HEIGHT
IN FRAME CALL STN.
CALL STN. TYPE
CALL STN. KEYED
CALL STN. STOP BUTTON
CALL STN. MOUNTING
INSULATED PRODOOR KIT

LANDING 1	LANDING 2	LANDING 3	LANDING 4
Fire Rated Pro Door	Fire Rated Pro Door	Fire Rated Pro Door	
c	a	c	
lh	rh	lh	
Not Applicable	Not Applicable	Not Applicable	
WR500 Lock (24V)	WR500 Lock (24V)	Pro Lock (24V) Indoor only	
Pro Door Opener II	Pro Door Opener II	None	
no	no	no	
Call/Send Buttons	Call/Send Buttons	Call/Send Buttons	
On/Off Pos. Removeable	Off Pos. Removeable	Not Required	
no	no	no	
Flush Mounted Remote	Flush Mounted Remote	Surface Mounted Remote	
No	Yes	No	

OPTIONS PROVIDED

EMERGENCY PENDENT PLUG IN MANUAL LOWERING BOX
WINGS: no
TOUCH UP PAINT: 7 can(s)
BUILDING: Public Building
LIGHT CURTAIN: no
PHONE OR PHONE PLUG: Hands free phone
FLOOD SWITCH: no
REMOTE MACHINE ROOM: Not required
LOCATION: INDOOR
RAMP: No Ramp Required
EXTRA KEYS: 0
WALL FASTENERS: lag
UNDERPAN SENSOR: no
UNIT COLOUR: Standard Color - Almond Beige
FLOOR: Anti-Skid Paint (Grey)
FOLD SEAT: no

OFFICE USE ONLY:	
CONFIGURATION VERSION STAMP:	0.0
MODULE VERSION STAMP:	B-S-86.3

CUSTOMER: ACCESS ELEVATOR INC. (WI)	DATE: 03-14-23	Part No. V-1504
PROJECT: AGAPE COMMUNITY CHURCH	REVISION DATE: 03-14-23	Variant No. 1087963
ADDRESS: 449 W. WISCONSIN AVENUE, PEWAUKEE WISCONSIN, USA, 53072	COMPLETED BY: JRW/TA/AB/UNCS	
	JOB No. P00000	SHEET No. 2 OF 6

POWER UNIT

MOTOR: 3.0 HP, 24V DC
FLOW: 1.15 Gal/min (4.35L/min)

CAB FINISH


Steel W Paint


HYDRAULIC DATA

OIL TYPE: UNIVIS 32 INDOOR
DEXRON ATF OUTDOOR
GALLONS REQ'D: 1.5 Gal (5.68 L)
MAXIMUM WORKING PRESSURE: 2500 psi (17.2 MPa)
RELIEF PRESSURE: WPx125% MAX.
MAXIMUM RELIEF PRESSURE: 2500 psi (17.2 MPa)
HYDRAULIC HOSE: 1/4" (6.4 mm) ID
BURST: 20000 psi (137.9 MPa)
FITTINGS: 1/4" (6.4 mm) NPT MALE

SUSPENSION CHAIN

2X #50 ROLLER CHAIN
BREAKING STRENGTH: 7171 lbs (31.9 kN) each
SAFETY BRAKE: TYPE 'A'

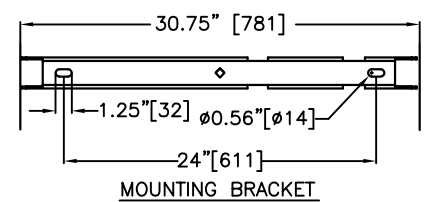



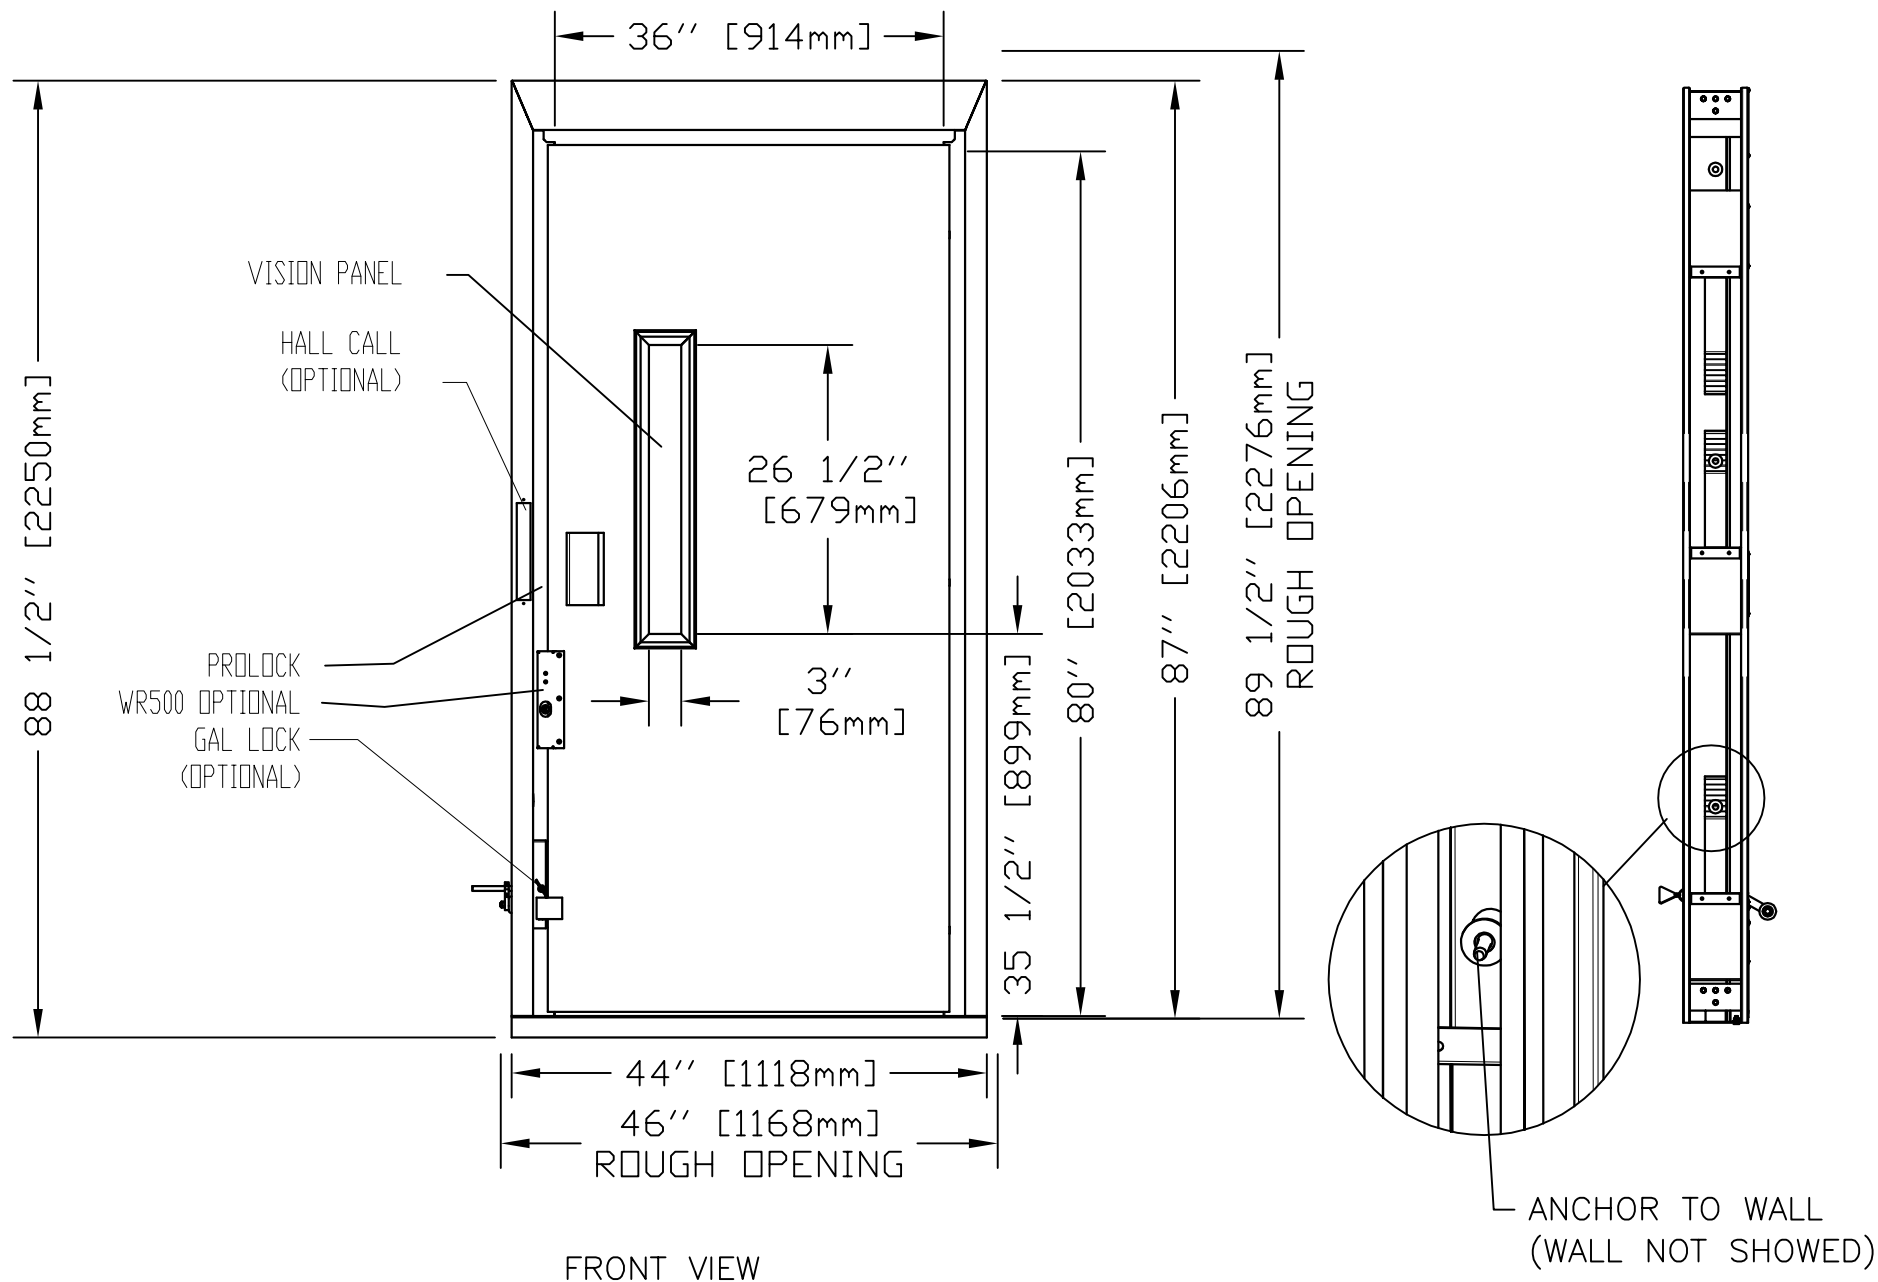


NOTES:

- A:) DRYWALL OR PARGING (BY OTHERS)AS REQ'D.
- B:) SEE DATASHEET OF THE INSTALLATION DRAWING FOR LANDING ENTRANCE SCHEDULE AND RUNNING CLEARANCE.
- C:) ALL INFORMATION IS SUBJECT TO CHANGE.

GENERAL INFORMATION:

- EACH LANDING ENTRANCE SHALL BE SUPPLIED AS A FINISHED ASSEMBLY WITH DOOR AND FRAME BLANKED, REINFORCED, DRILLED AND TAPPED FOR ALL COMPONENTS DETAILED, READY FOR INSTALLATION.
- FRAMES SHALL BE 16 GA.,FULLY WELDED CONSTRUCTION WITH ALL WELDED JOINTS GROUND TO A SMOOTH, UNIFORM FINISH
- DOORS SHALL BE 18 GA., 2" THICK, SWINGING, FLUSH, STEEL REINFORCED CONSTRUCTION COMPLETE WITH GLASS LITE(S) AS INDICATED. DOORS/FRAMES FABRICATED WITH GALVANNEALED PRODUCT A40 COATED WITH PRIMER PAINT WITH SOME FACTORY APPLIED TOUCH-UP. REFER TO OUR INSTRUCTIONS IN MANUAL 000919 TO PAINT OVER THE PRIMER.
- 1.5 HOURS UL/ULC LABELLED ENTRANCES PROVIDED AS INDICATED.
- AUTO DOOR: OPERATOR IS PROVIDED.

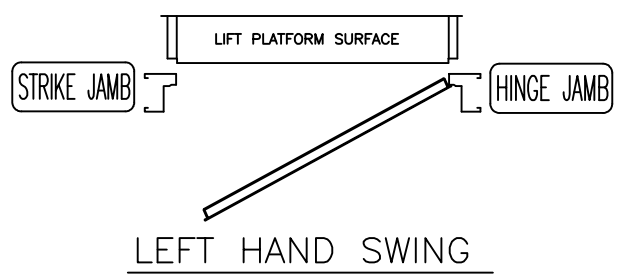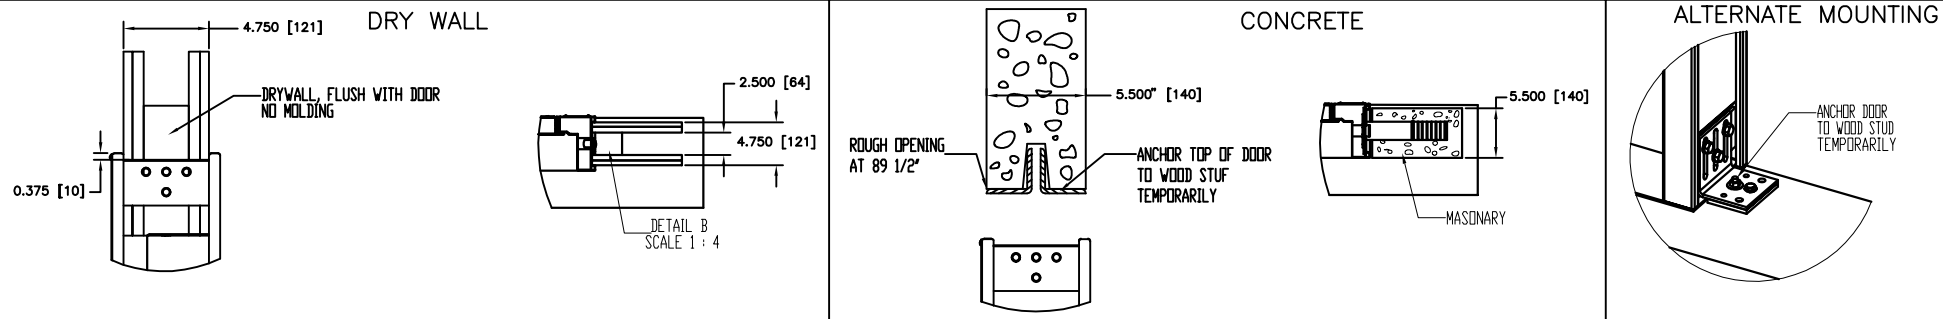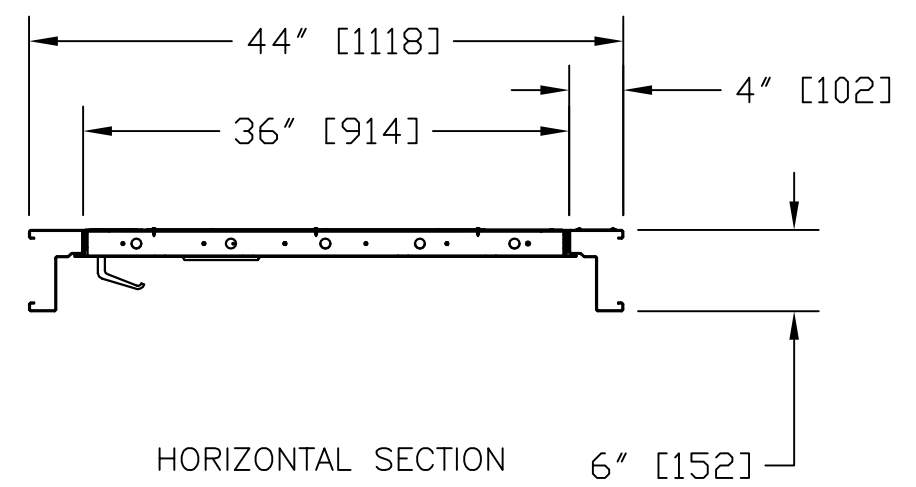

First Level Door


FIREPRO DOORS
ENCLOSED VERTICAL WHEELCHAIR PLATFORM LIFT

CUSTOMER: ACCESS ELEVATOR INC. (WI)
PROJECT: AGAPE COMMUNITY CHURCH
ADDRESS: 449 W. WISCONSIN AVENUE, PEWAUKEE WISCONSIN, USA, 53072

OFFICE USE ONLY:	
CONFIGURATION VERSION STAMP:	0.0
MODULE VERSION STAMP:	B-S-8.6.3

Part No.	V-1504
Variant No.	1087963
DATE:	03-14-23
REVISION DATE:	03-14-23
COMPLETED BY:	WHEELCHAIR ADVANCES
JOB No.	P00000
SHEET No.	3 OF 6





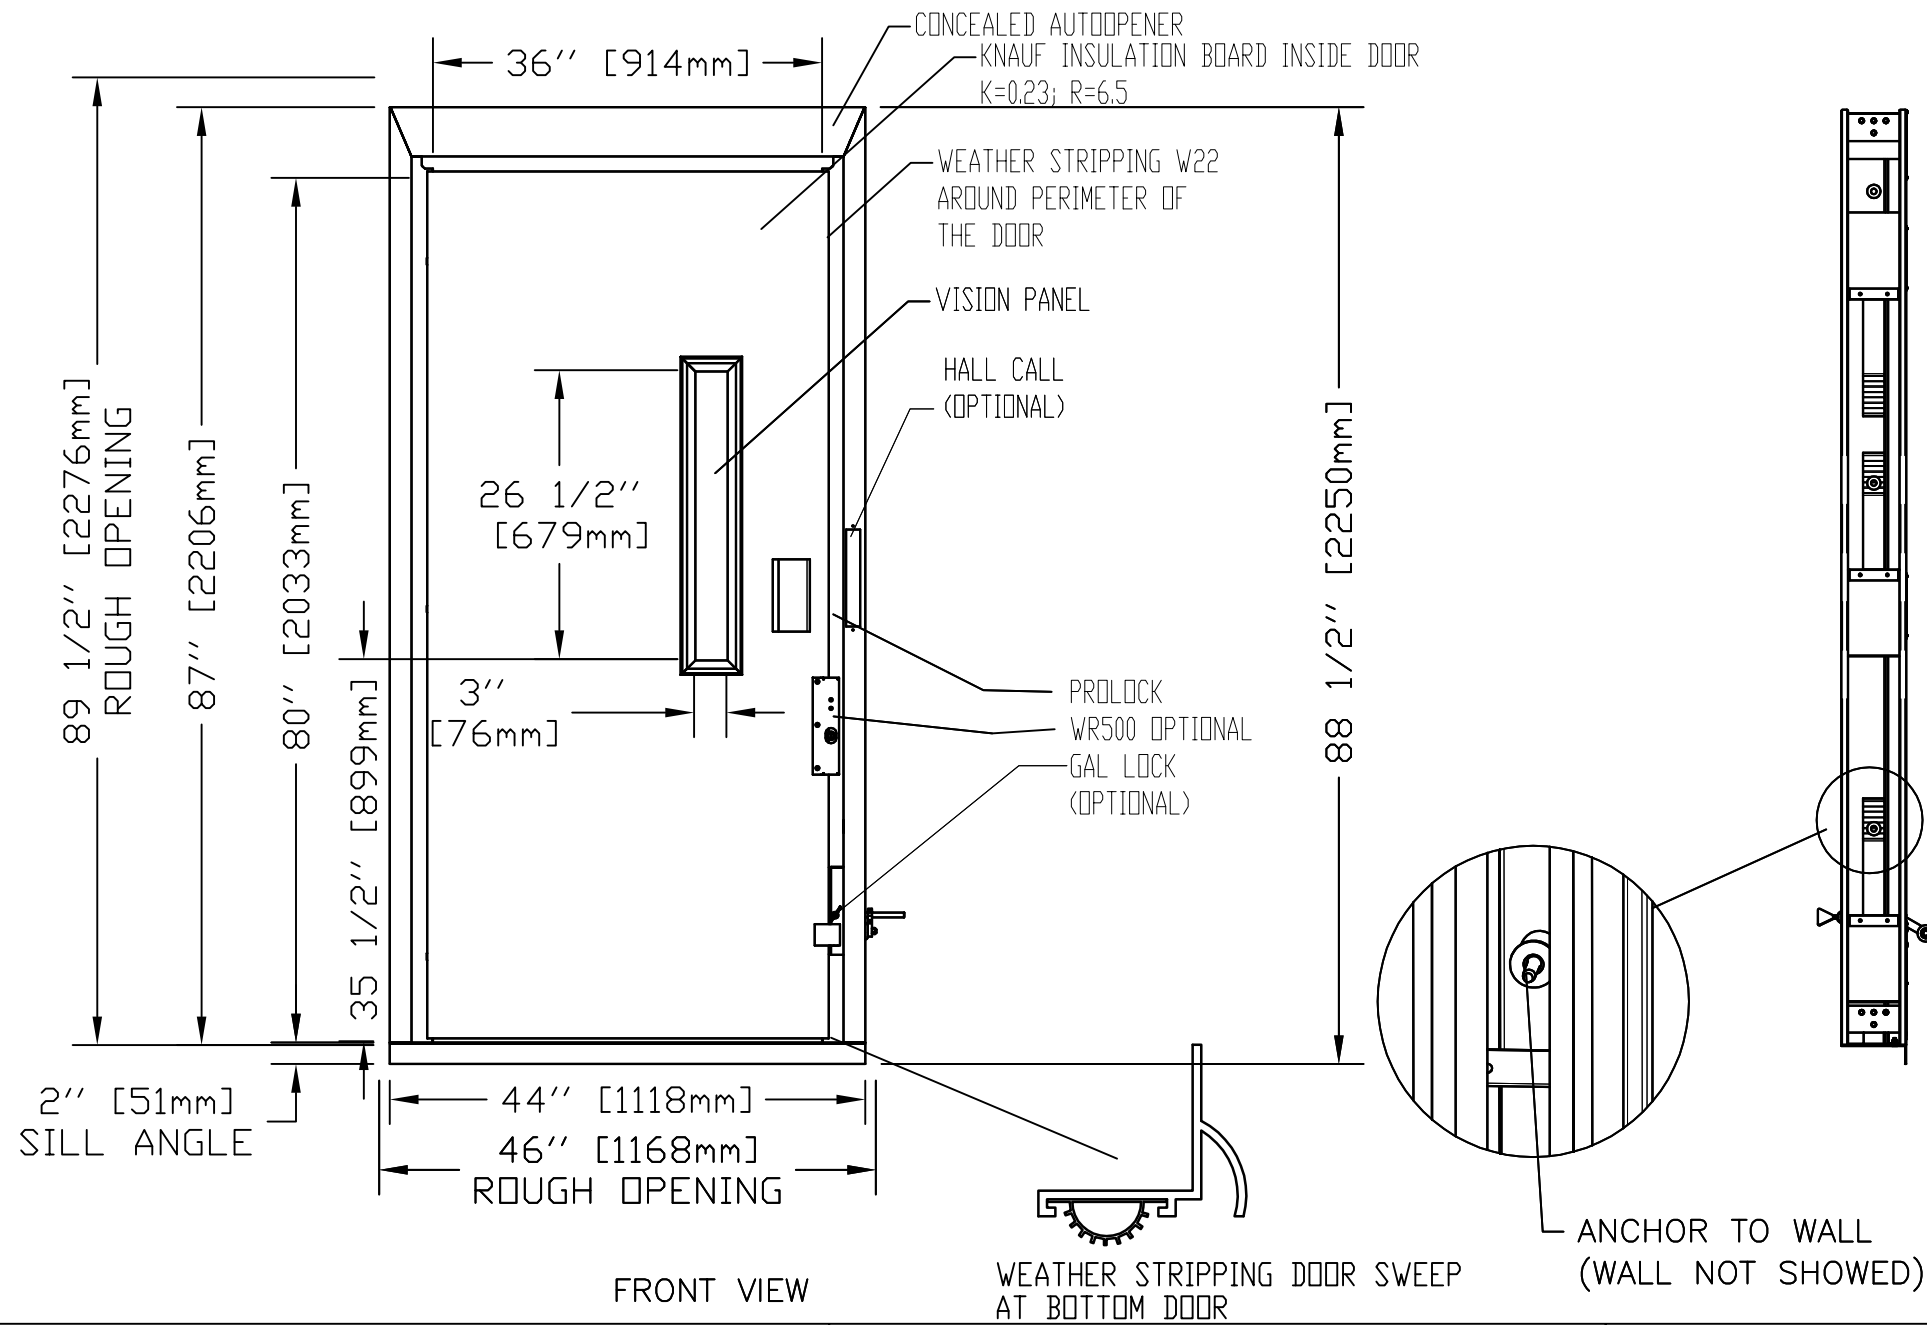


NOTES:

- A:) DRYWALL OR PARGING (BY OTHERS)AS REQ'D.
- B:) SEE DATASHEET OF THE INSTALLATION DRAWING FOR LANDING ENTRANCE SCHEDULE AND RUNNING CLEARANCE.
- C:) ALL INFORMATION IS SUBJECT TO CHANGE.

GENERAL INFORMATION:

- EACH LANDING ENTRANCE SHALL BE SUPPLIED AS A FINISHED ASSEMBLY WITH DOOR AND FRAME BLANKED, REINFORCED, DRILLED AND TAPPED FOR ALL COMPONENTS DETAILED, READY FOR INSTALLATION.
- FRAMES SHALL BE 16 GA.,FULLY WELDED CONSTRUCTION WITH ALL WELDED JOINTS GROUND TO A SMOOTH, UNIFORM FINISH
- DOORS SHALL BE 18 GA., 2" THICK, SWINGING, FLUSH, STEEL REINFORCED CONSTRUCTION COMPLETE WITH GLASS LITE(S) AS INDICATED. DOORS/FRAMES FABRICATED WITH GALVANNEALED PRODUCT A40 COATED WITH PRIMER PAINT WITH SOME FACTORY APPLIED TOUCH-UP. REFER TO OUR INSTRUCTIONS IN MANUAL 000919 TO PAINT OVER THE PRIMER.
- 1.5 HOURS UL/ULC LABELLED ENTRANCES PROVIDED AS INDICATED.
- AUTO DOOR: OPERATOR IS PROVIDED.

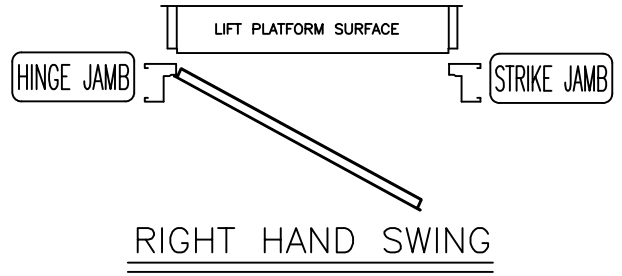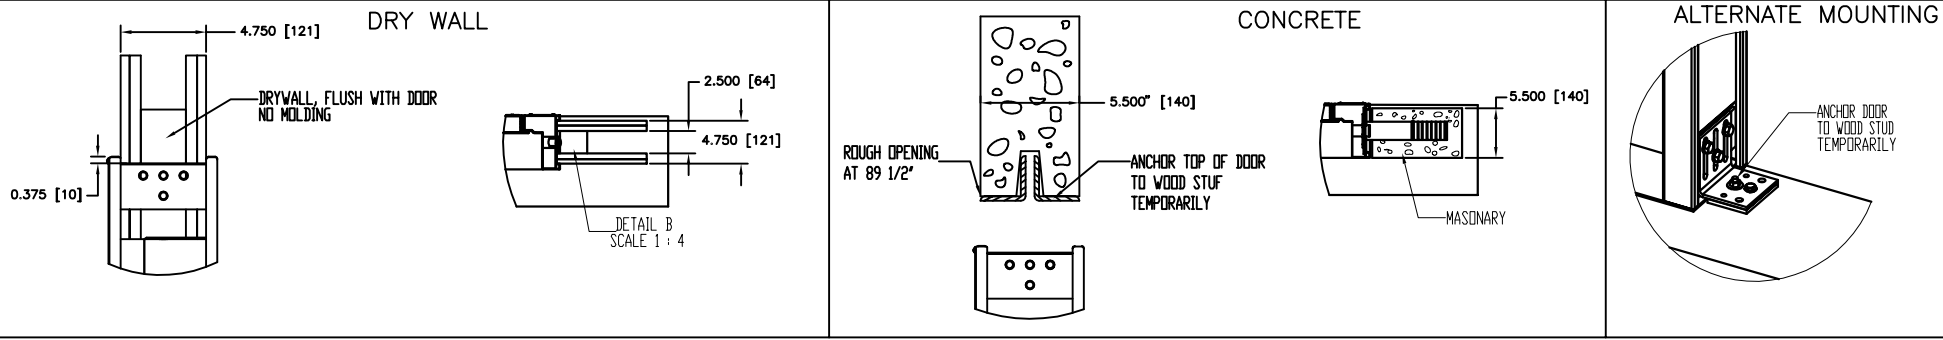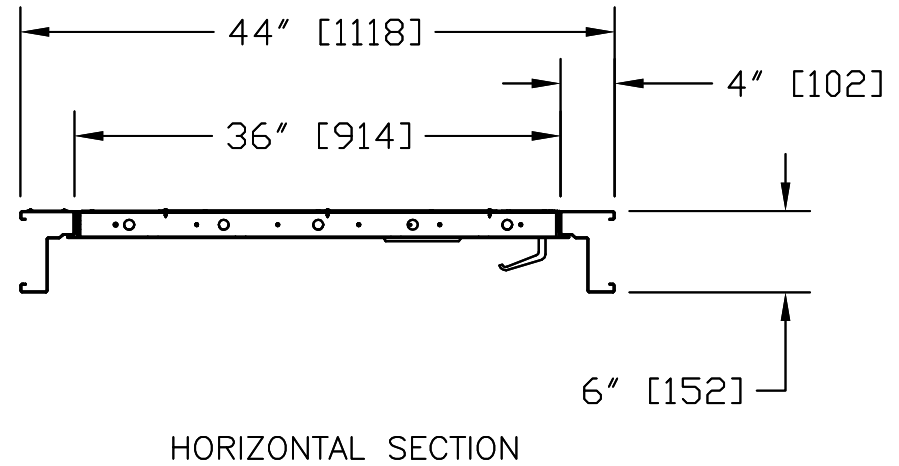

EXTERIOR DOOR
Second Level Door


FIREPRO DOORS
ENCLOSED VERTICAL WHEELCHAIR PLATFORM LIFT

CUSTOMER: ACCESS ELEVATOR INC. (WI)
PROJECT: AGAPE COMMUNITY CHURCH
ADDRESS: 449 W. WISCONSIN AVENUE, PEWAUKEE WISCONSIN, USA, 53072

OFFICE USE ONLY:	
CONFIGURATION VERSION STAMP:	0.0
MODULE VERSION STAMP:	B-S-8.6.3

Part No.	V-1504
Variant No.	1087963
DATE:	03-14-23
REVISION DATE:	03-14-23
COMPLETED BY:	JEFFREY HARRIS
JOB No.	P00000
SHEET No.	4 OF 6



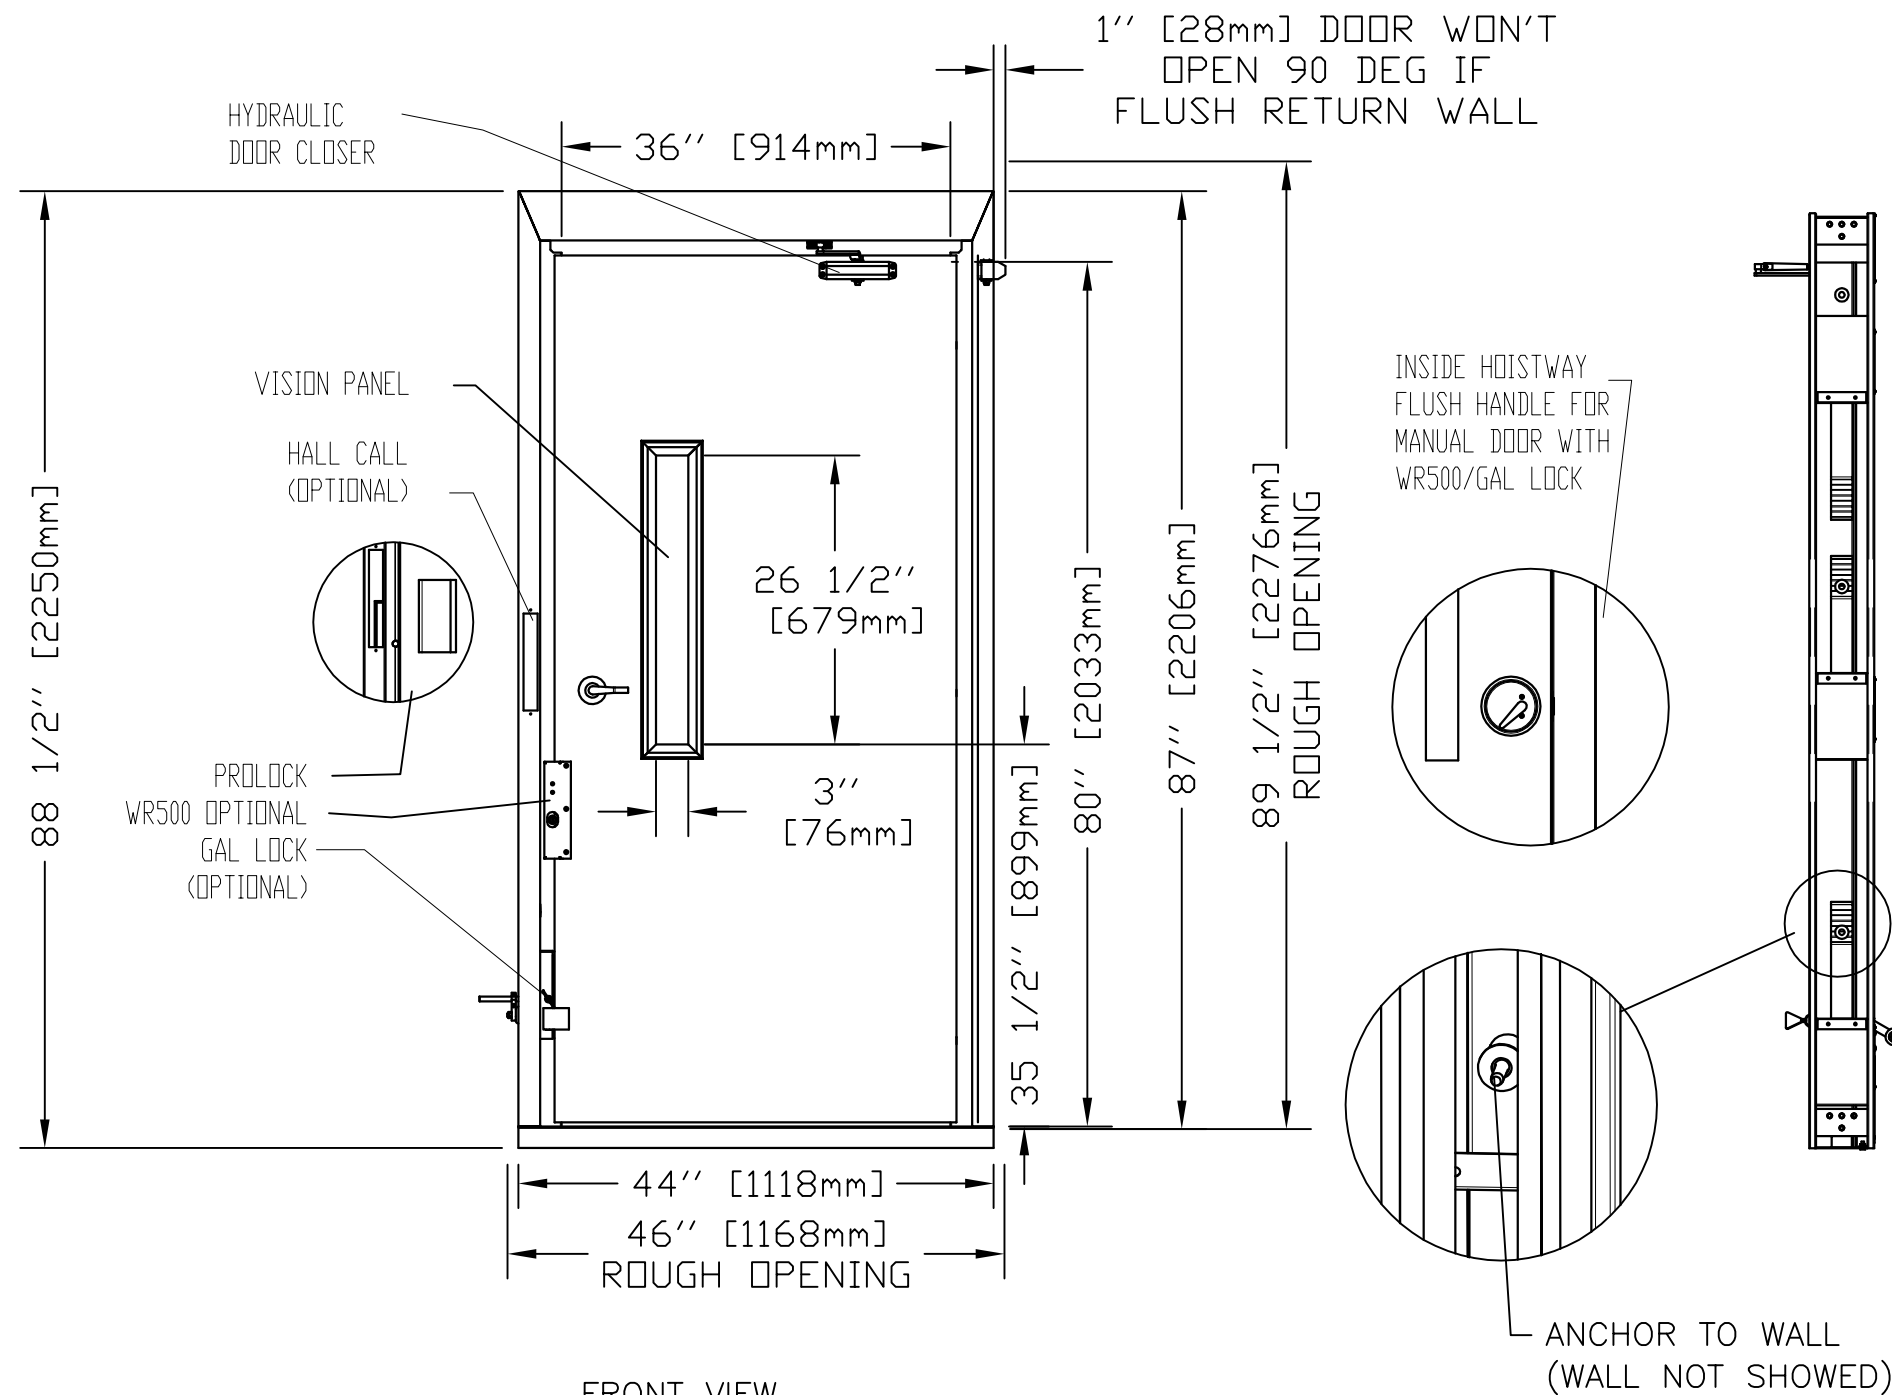


NOTES:

- A:) DRYWALL OR PARGING (BY OTHERS)AS REQ'D.
- B:) SEE DATASHEET OF THE INSTALLATION DRAWING FOR LANDING ENTRANCE SCHEDULE AND RUNNING CLEARANCE.
- C:) ALL INFORMATION IS SUBJECT TO CHANGE.





GENERAL INFORMATION:

- EACH LANDING ENTRANCE SHALL BE SUPPLIED AS A FINISHED ASSEMBLY WITH DOOR AND FRAME BLANKED, REINFORCED, DRILLED AND TAPPED FOR ALL COMPONENTS DETAILED, READY FOR INSTALLATION.
- FRAMES SHALL BE 16 GA.,FULLY WELDED CONSTRUCTION WITH ALL WELDED JOINTS GROUND TO A SMOOTH, UNIFORM FINISH
- DOORS SHALL BE 18 GA., 2" THICK, SWINGING, FLUSH, STEEL REINFORCED CONSTRUCTION COMPLETE WITH GLASS LITE(S) AS INDICATED. DOORS/FRAMES FABRICATED WITH GALVANNEALED PRODUCT A40 COATED WITH PRIMER PAINT WITH SOME FACTORY APPLIED TOUCH-UP. REFER TO OUR INSTRUCTIONS IN MANUAL 000919 TO PAINT OVER THE PRIMER.
- 1.5 HOURS UL/ULC LABELLED ENTRANCES PROVIDED AS INDICATED.
- MANUAL DOOR: HYDRAULIC DOOR CLOSER PROVIDED.

FRONT VIEW

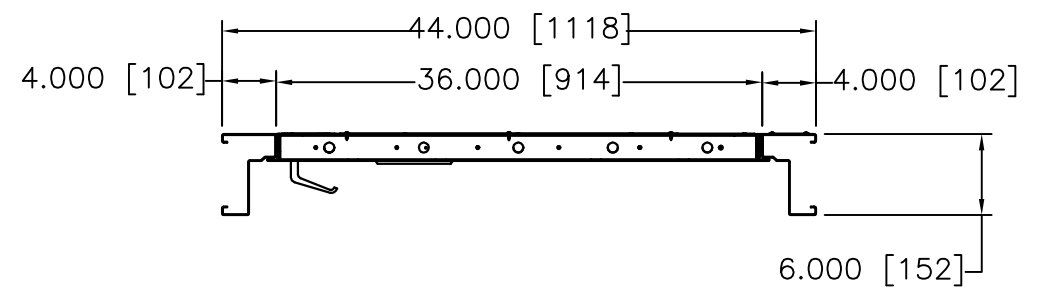

HORIZONTAL SECTION

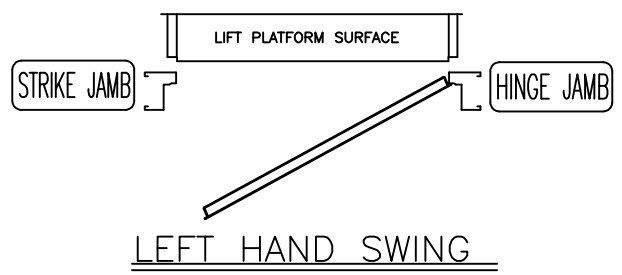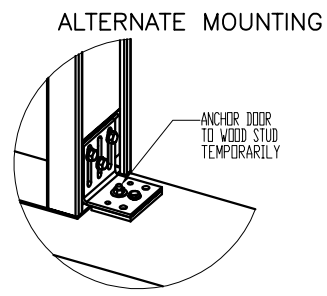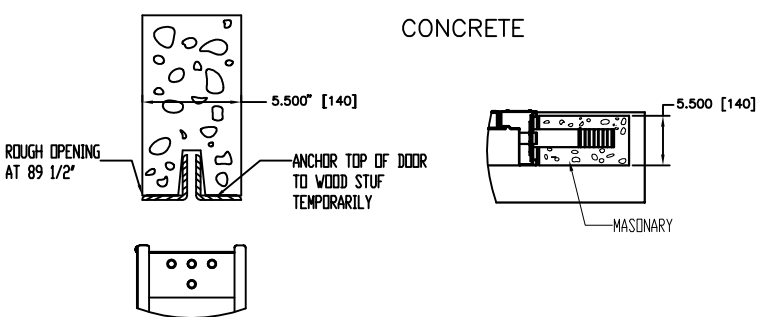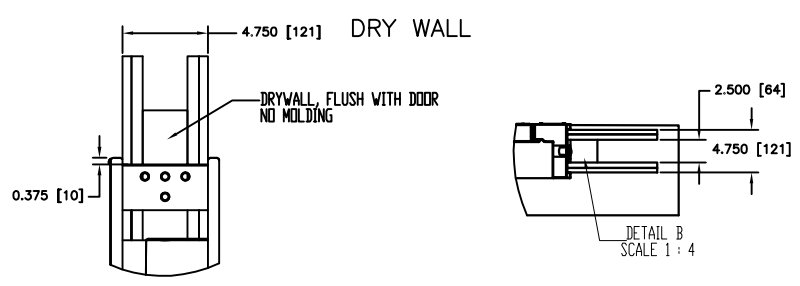

Third Level Door



FIREPRO DOORS
ENCLOSED VERTICAL WHEELCHAIR PLATFORM LIFT

CUSTOMER: ACCESS ELEVATOR INC. (WI)
PROJECT: AGAPE COMMUNITY CHURCH
ADDRESS: 449 W. WISCONSIN AVENUE, PEWAUKEE WISCONSIN, USA, 53072


OFFICE USE ONLY:	
CONFIGURATION VERSION STAMP:	0.0
MODULE VERSION STAMP:	B-S-8.6.3

Part No.	V-1504
Variant No.	1087963
DATE:	03-14-23
REVISION DATE:	03-14-23
COMPLETED BY:	JEFFREY H. ADVANCE
JOB No.	P00000
SHEET No.	5 OF 6



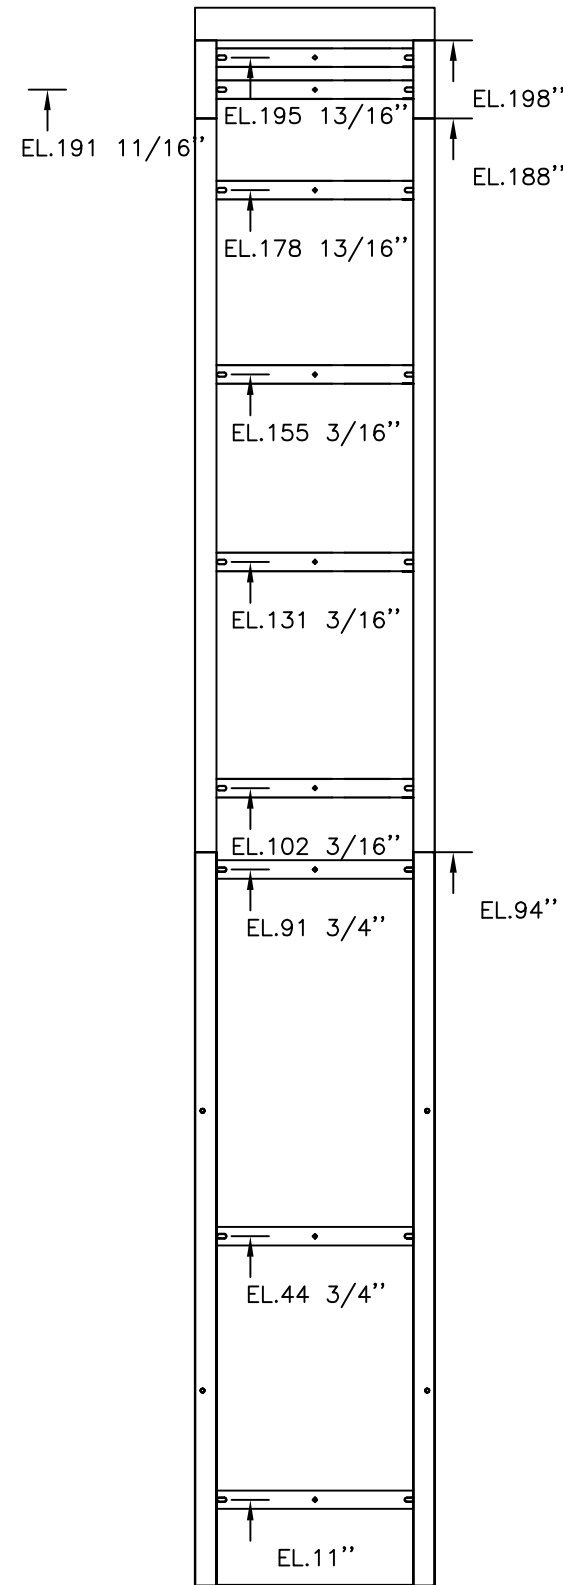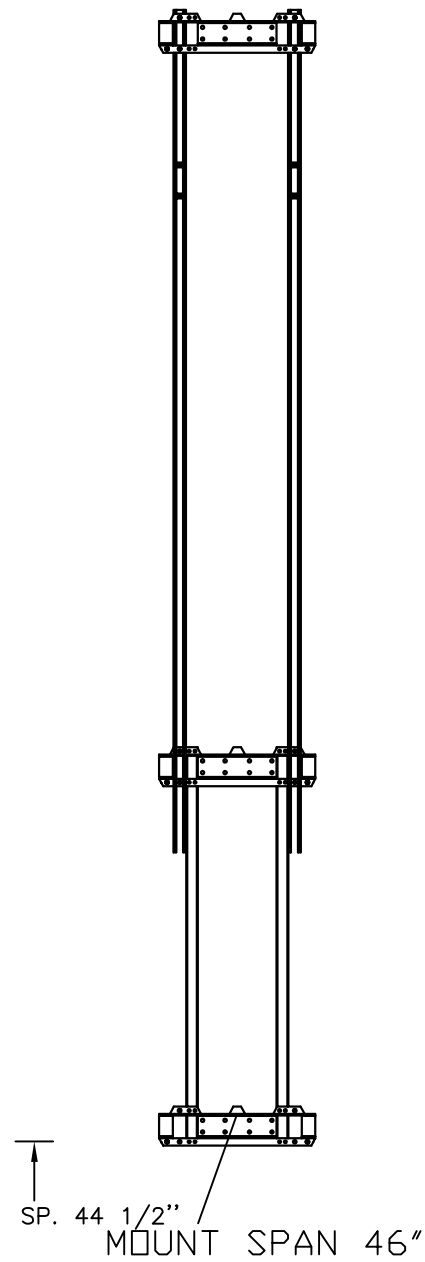

EL: MOUNTING BRACKET POSITION

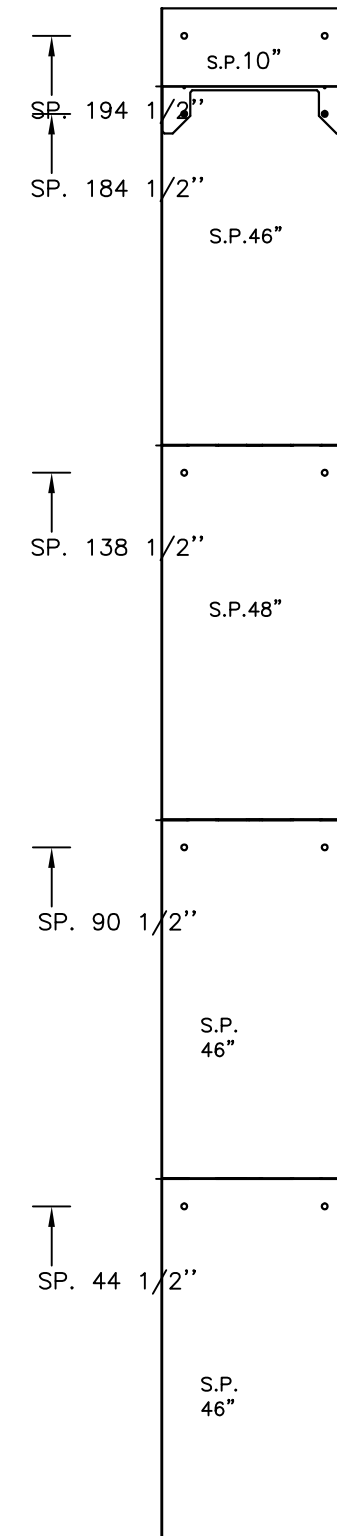

SP: SERVICE PANEL

LOADS CALCULATED ON BASED ON ANCHOR POINTS EVERY 48\"/>

ELEVATION VIEWS
ENCLOSED VERTICAL WHEELCHAIR PLATFORM LIFT

OFFICE USE ONLY:		Part No. V-1504
CONFIGURATION VERSION STAMP:	0.0	Variant No. 1087963
MODULE VERSION STAMP:	B-S-8.6.3	
CUSTOMER:	ACCESS ELEVATOR INC. (WI)	DATE: 03-14-23
PROJECT:	AGAPE COMMUNITY CHURCH	REVISION DATE: 03-14-23
ADDRESS:	449 W. WISCONSIN AVENUE, PEWAUKEE WISCONSIN, USA, 53072	COMPLETED BY: JEREMY LABOUCHE


savaria

JOB No. P00000 SHEET No. 6 OF 6

agape

COMMUNITY CHURCH

449 W Wisconsin Ave, Pewaukee, WI 53072

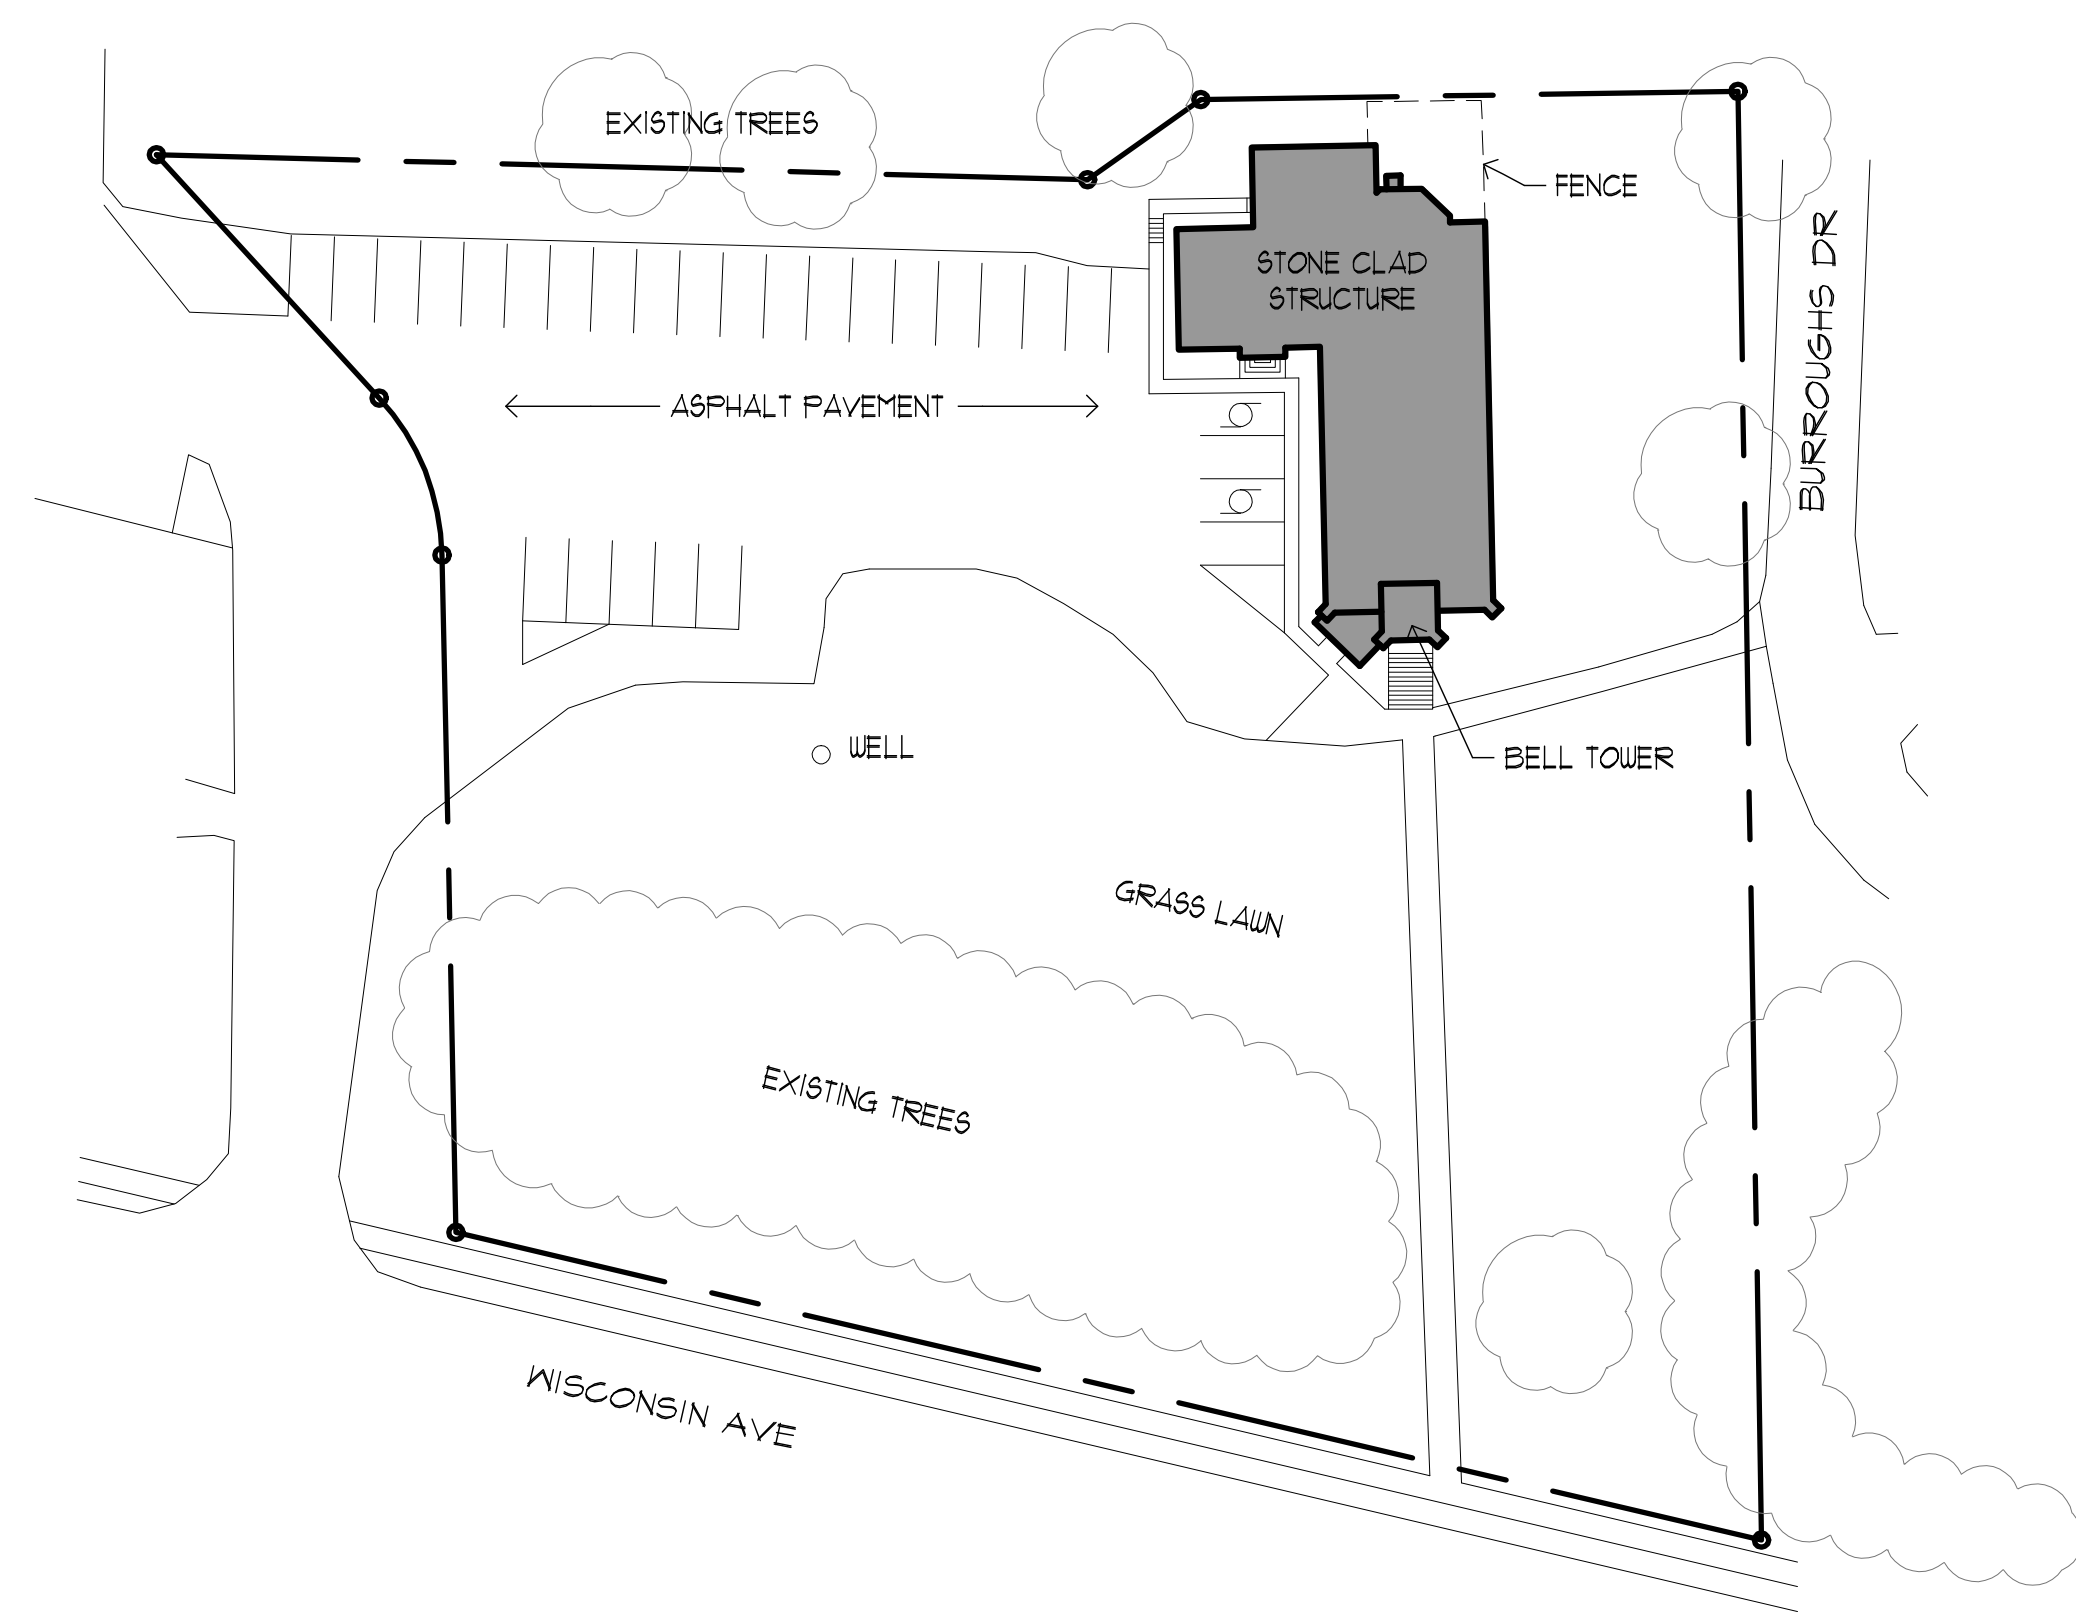

THIS PLAN IS FOR GENERAL SITE INFORMATION ONLY - NO EXTERIOR WORK AT THIS TIME

EXISTING SITE PLAN

SCALE: 1 = 40'
 SITE AREA: 1.66 ACRES
 TOTAL EXISTING PARKING: 29 SPACES (2 ACCESSIBLE) - UNCHANGED

OWNER:
 AGAPE COMMUNITY CHURCH

CHURCH OFFICE: PO BOX 392
 PEWAUKEE, WI 53072

GENERAL PROJECT DATA:

GOVERNING CODES:
 ARCH - 2015 IBC
 HVAC - 2015 IMC
 ELECTRICAL - NEC CURRENT EDITION
 PLUMBING - STATE OF WISCONSIN

PROJECT USE CLASSIFICATION:
 A-3 WORSHIP FACILITY

CONSTRUCTION CLASSIFICATION:
 TYP 5B - UNSPRINKLED
 1 STORY w/ BASEMENT

AREA SUMMARY:

1ST FLOOR ALLOWED	6,000 SF.
1ST FLOOR PROVIDED	4,300 SF. (UNCHANGED)
1ST FLOOR RENOVATED	1,000 SF.
BASEMENT ALLOWED	6,000 SF.
BASEMENT PROVIDED	4,300 SF. (UNCHANGED)
BASEMENT RENOVATED	1,000 SF.

2021-09-10 - PRINTED FOR BIDS AND PERMITS

SHEET INDEX:

ARCHITECTURAL



- A-1 SITE PLAN & PROJECT DATA
- A-2 FIRST FLOOR PLANS
- A-3 BASEMENT FLOOR PLANS
- A-4 RCP / INT ELEVS / SCHEDULES

PLUMBING (BY HARWOOD ENGINEERING)

- P-1 FOUNDATION PLUMBING PLAN
- P-2 FIRST FLOOR PLUMBING PLAN

MECH & ELEC TO BE DESIGN BUILD


VICINITY MAP

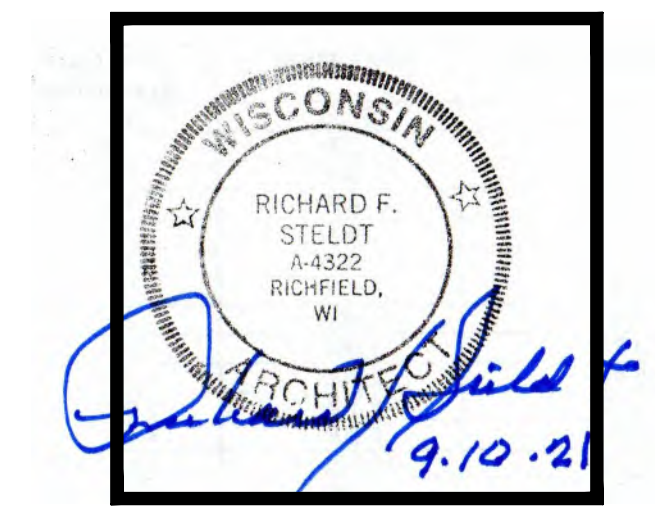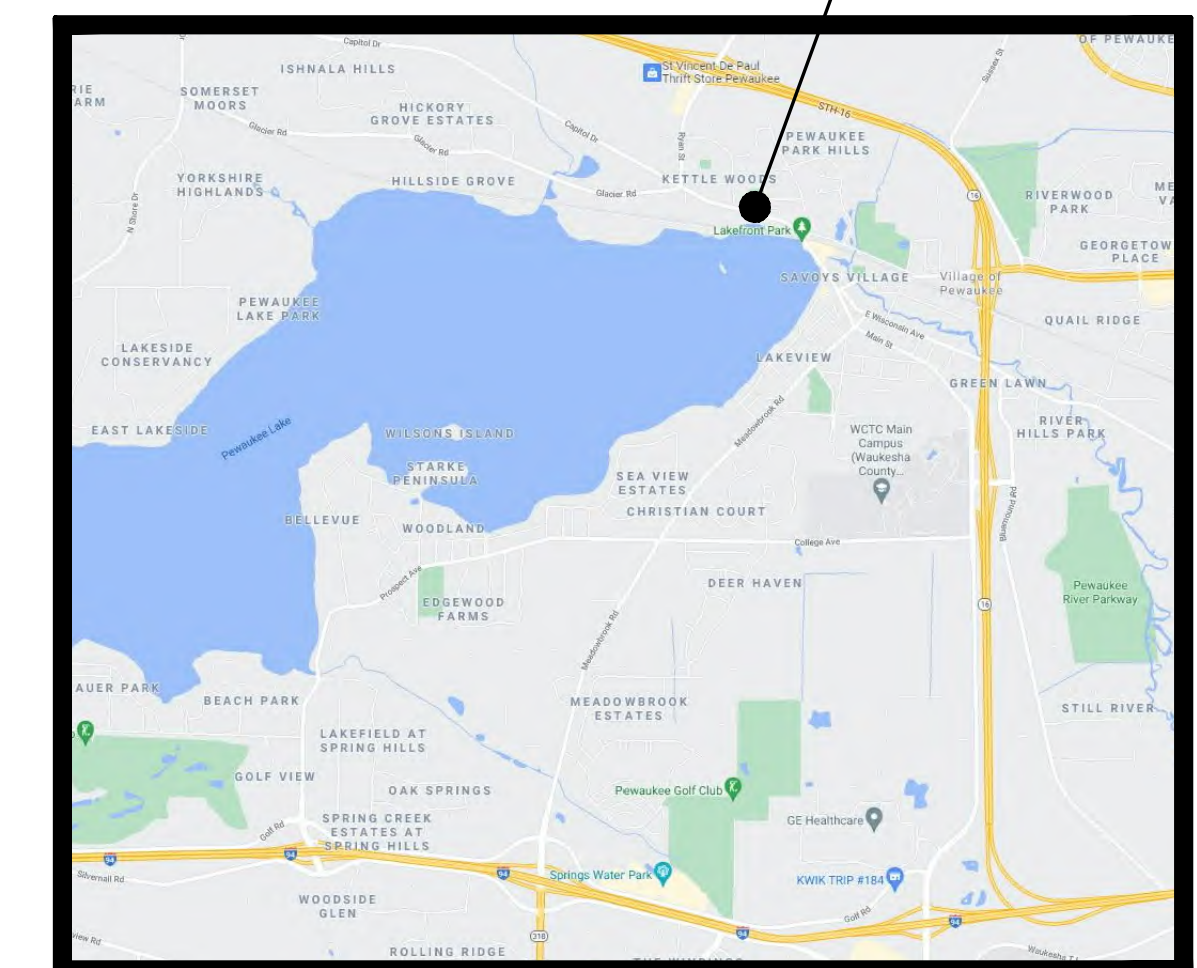

ARCHITECT SEAL
 SHEETS A-1 THRU A-4
 SEE INDIVIDUAL SHEETS FOR PLUMBING

PLAN CONDITIONALLY APPROVED
 No Variation of this Plan is Permitted without the Approval of E-Plan Exam and the Municipal Building Inspection Department. See Plan Review Letter and/or Permit for additional conditions that must be addressed during construction prior to inspection.
 Municipality: Village of Pewaukee
 Approved By: John J. Cunningham Date: 09/27/2021

RICHARD F. STELDT
 & ASSOCIATES, LTD.
ARCHITECTS
 (262) 502-4500
 N90 W16890 ROOSEVELT DR. #8, MENOMONEE FALLS, WI 53051

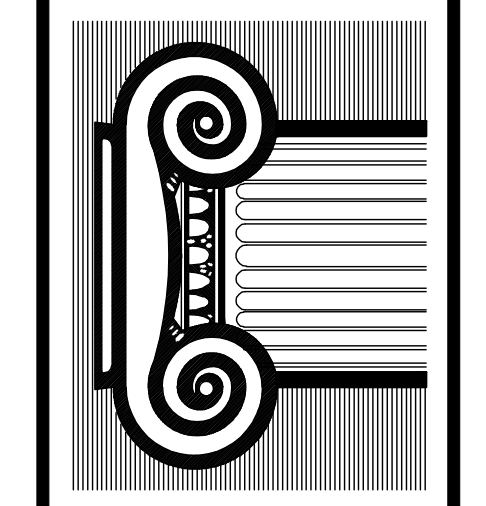

Drawn: AAP

Approved:

date comments

REVISIONS

Job: 2430-621


Date: 9-10-21

QUALITY OF DOCUMENTS: The documents and the ideas and designs incorporated herein are the property of Richard F. Steldt and Associates, Ltd. and are not to be used in whole or in part for any other project without the written authorization of Richard F. Steldt and Associates, Ltd.

agape
 COMMUNITY CHURCH


Sheet
A-1

SEE PLANS ON THIS SHEET FOR DEMOLITION AND RENOVATION IN THIS AREA

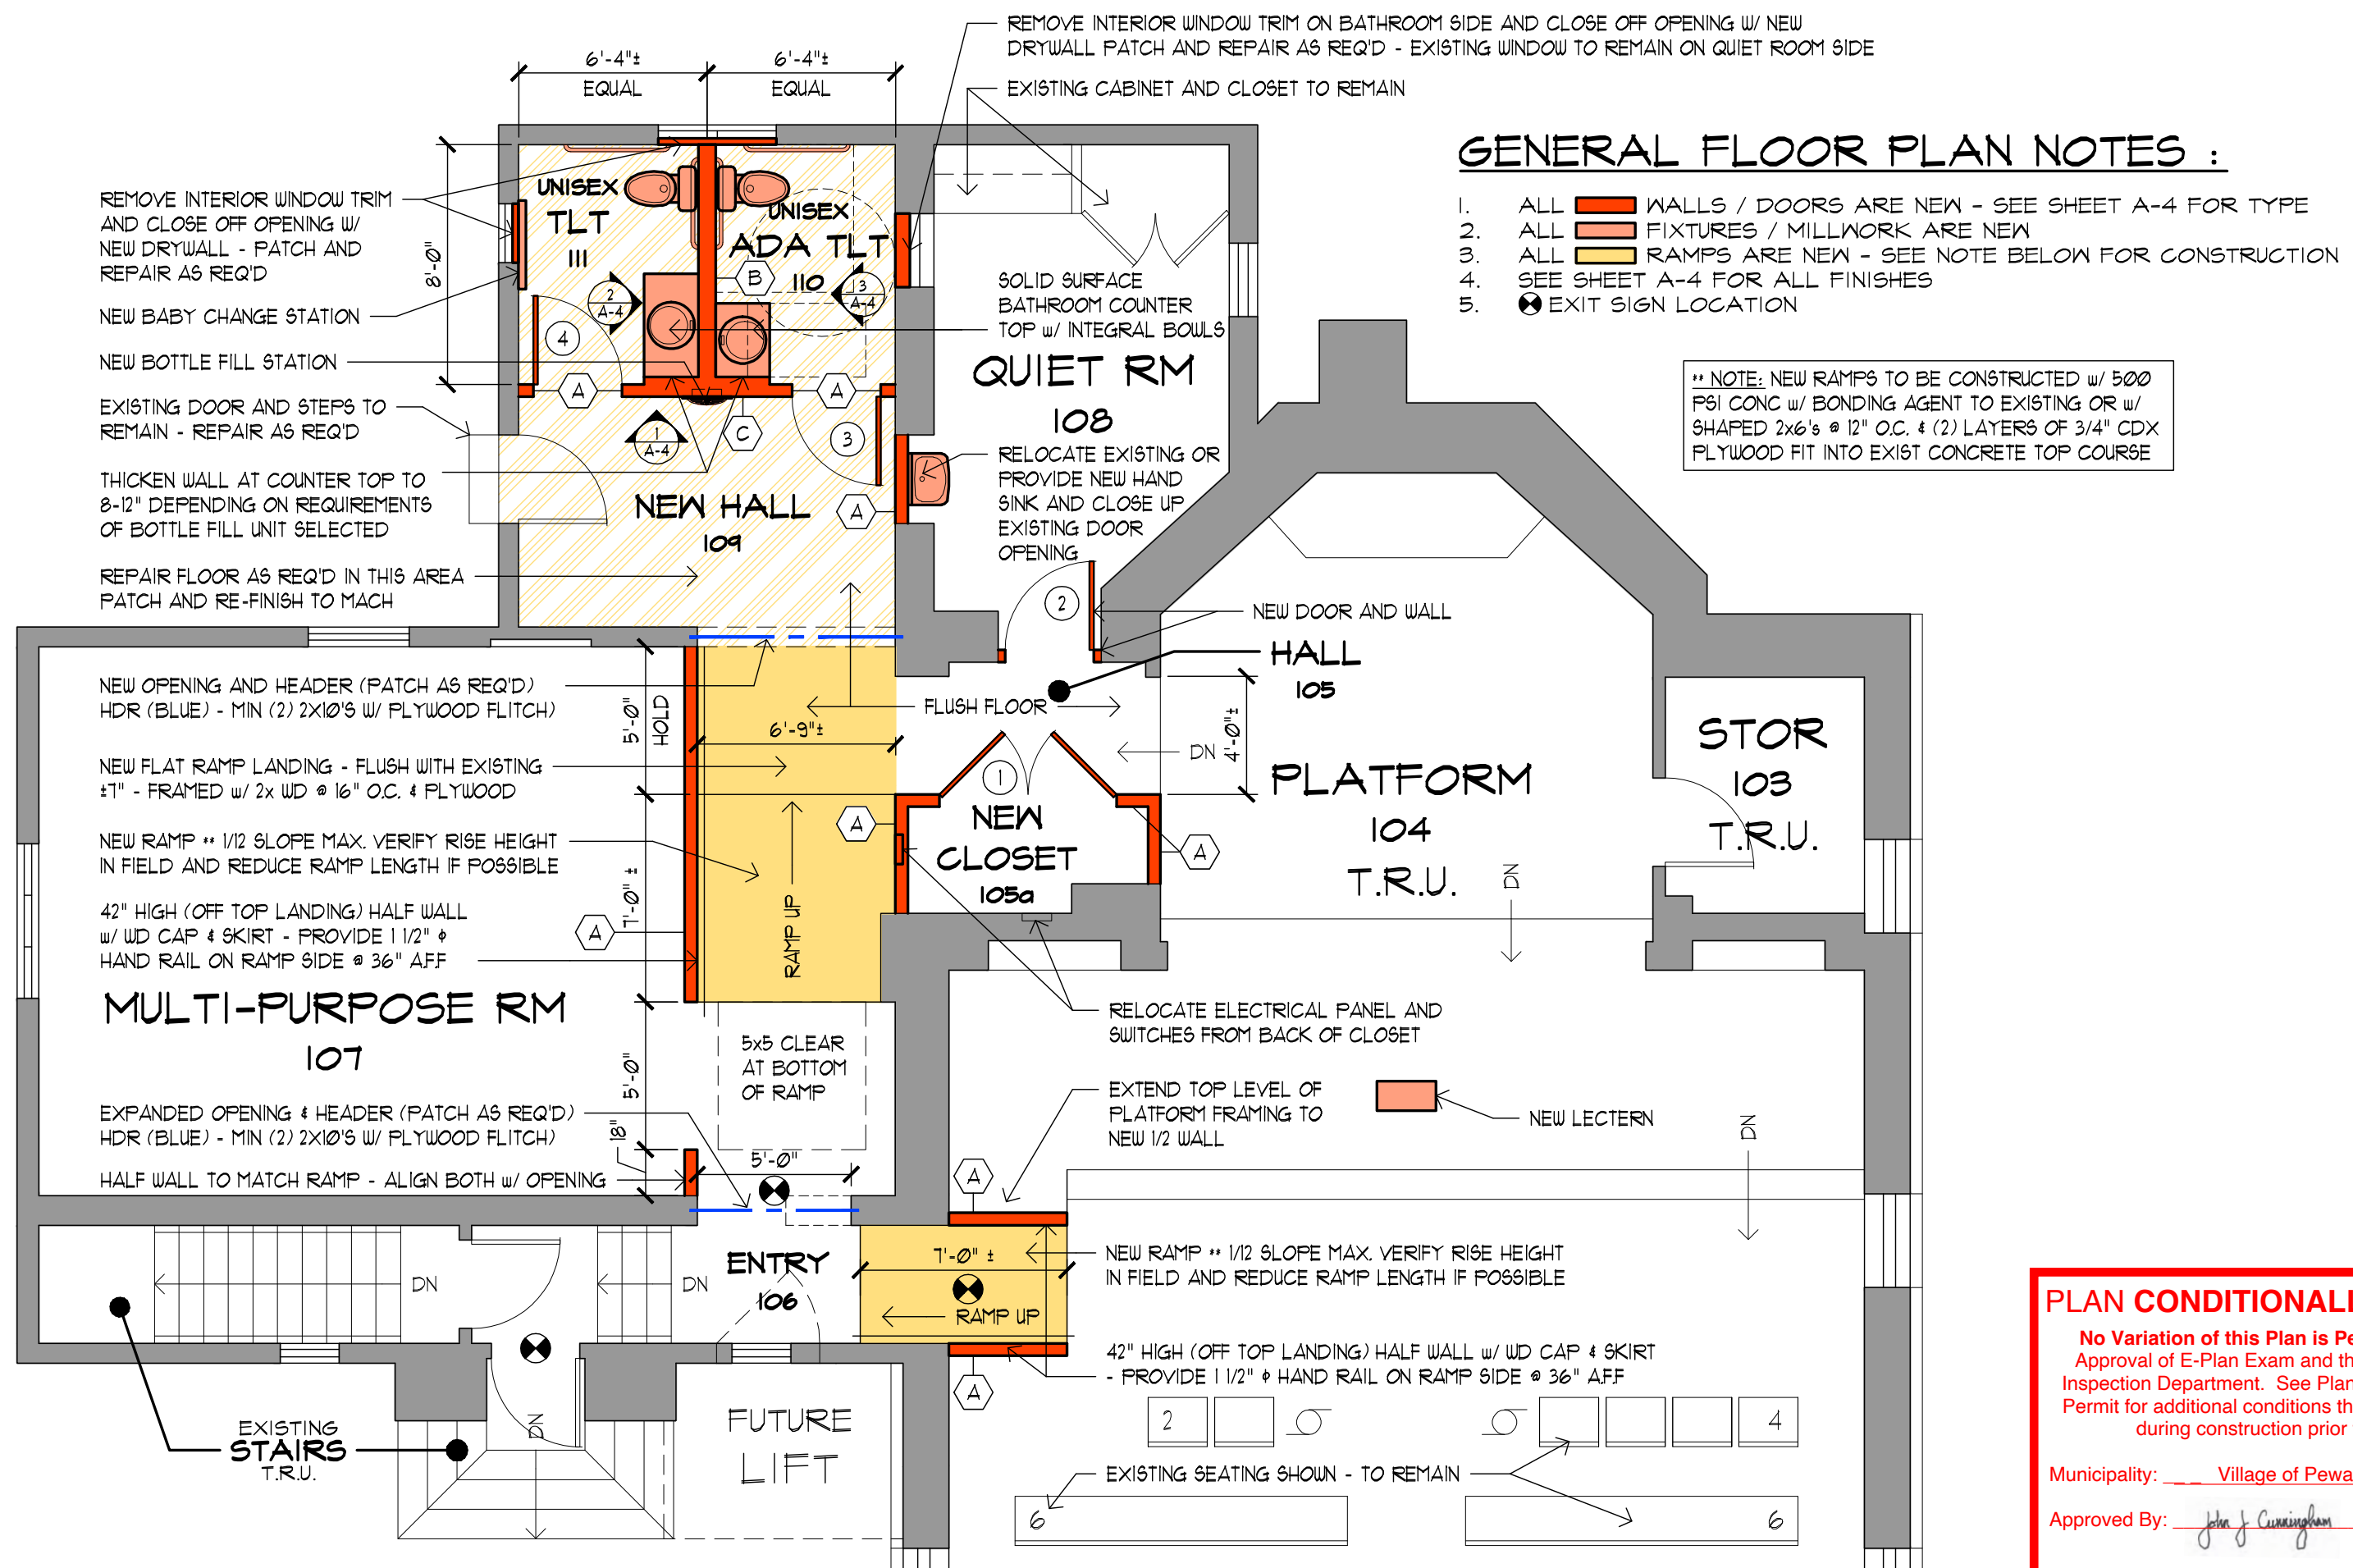


FIRST FLOOR RENO PLAN
 3/16" = 1'-0"
 T.R.U. = TO REMAIN UNCHANGED
 CHECK FINISH SCHEDULE FOR ANY FINISH CHANGES


PLAN CONDITIONALLY APPROVED
 No Variation of this Plan is Permitted without the Approval of E-Plan Exam and the Municipal Building Inspection Department. See Plan Review Letter and/or Permit for additional conditions that must be addressed during construction prior to inspection.
 Municipality: Village of Pewaukee
 Approved By: *John J. Cunningham* Date: 09/27/2021

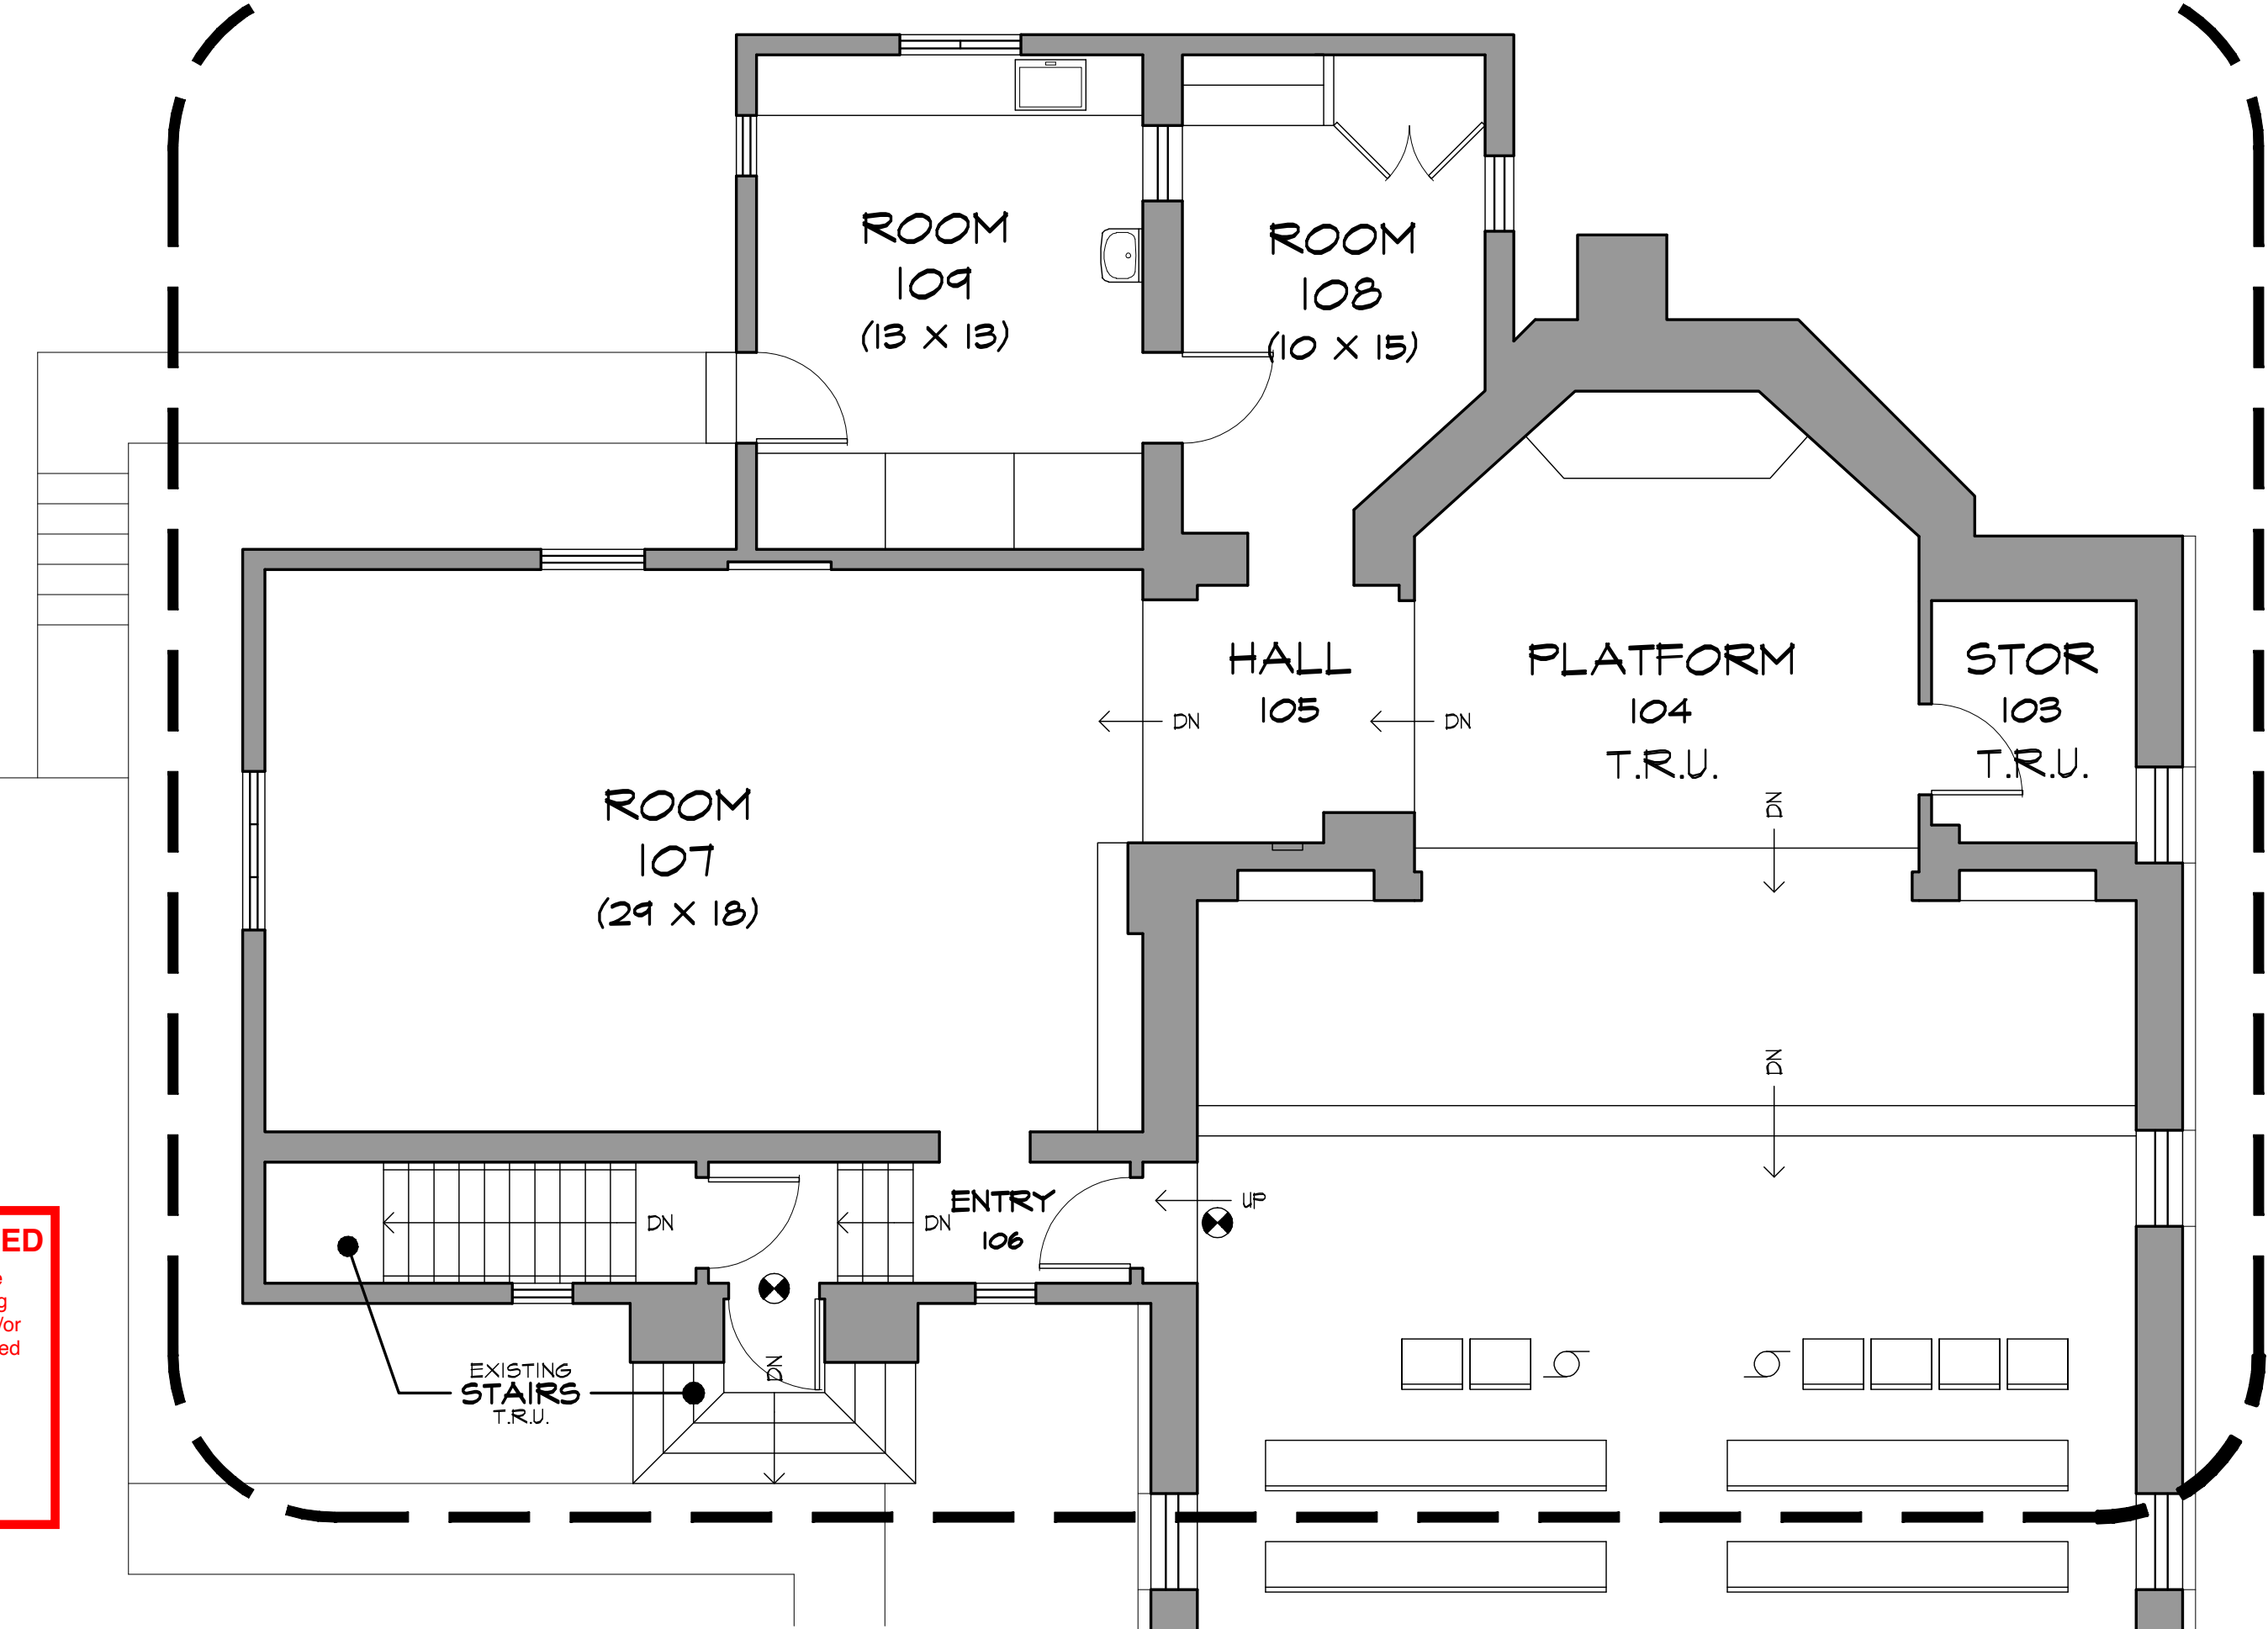


EXIST FIRST FLOOR PLAN
 3/16" = 1'-0"
 GROSS FLOOR AREA : 4,200 S.F.
 T.R.U. = TO REMAIN UNCHANGED
 CHECK FINISH SCHEDULE FOR ANY FINISH CHANGES

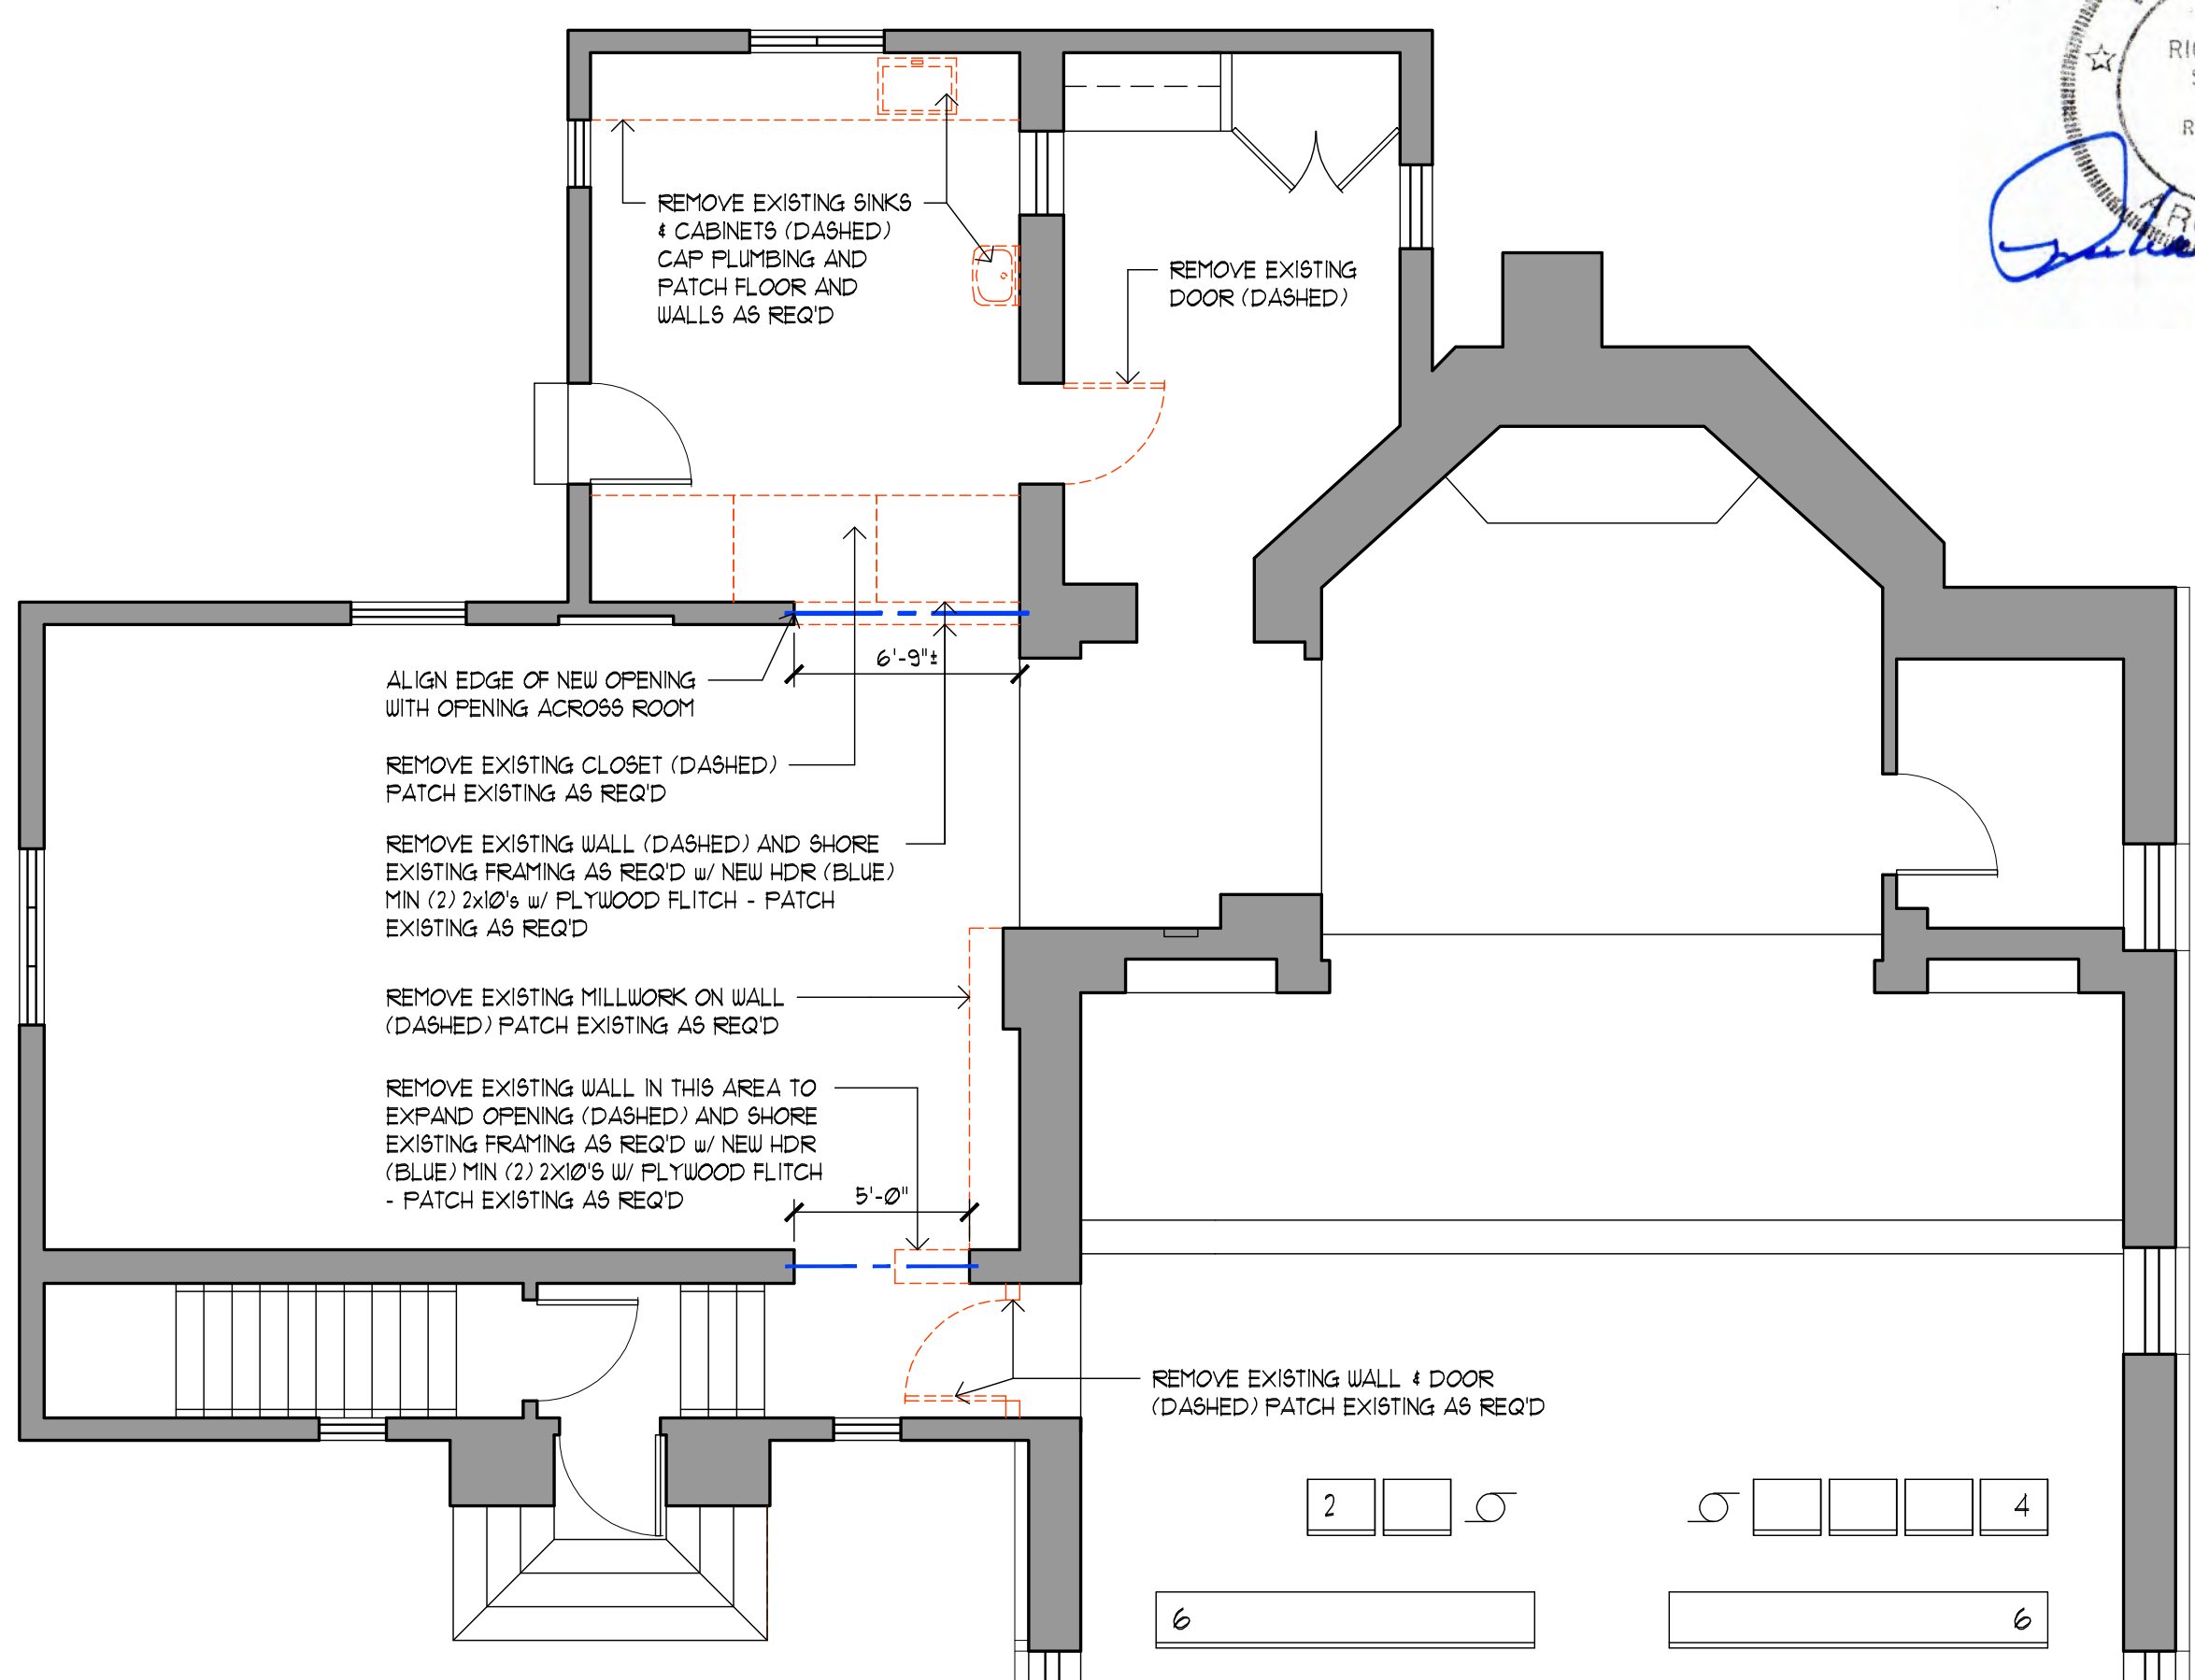

FIRST FLOOR DEMO PLAN
 3/16" = 1'-0"

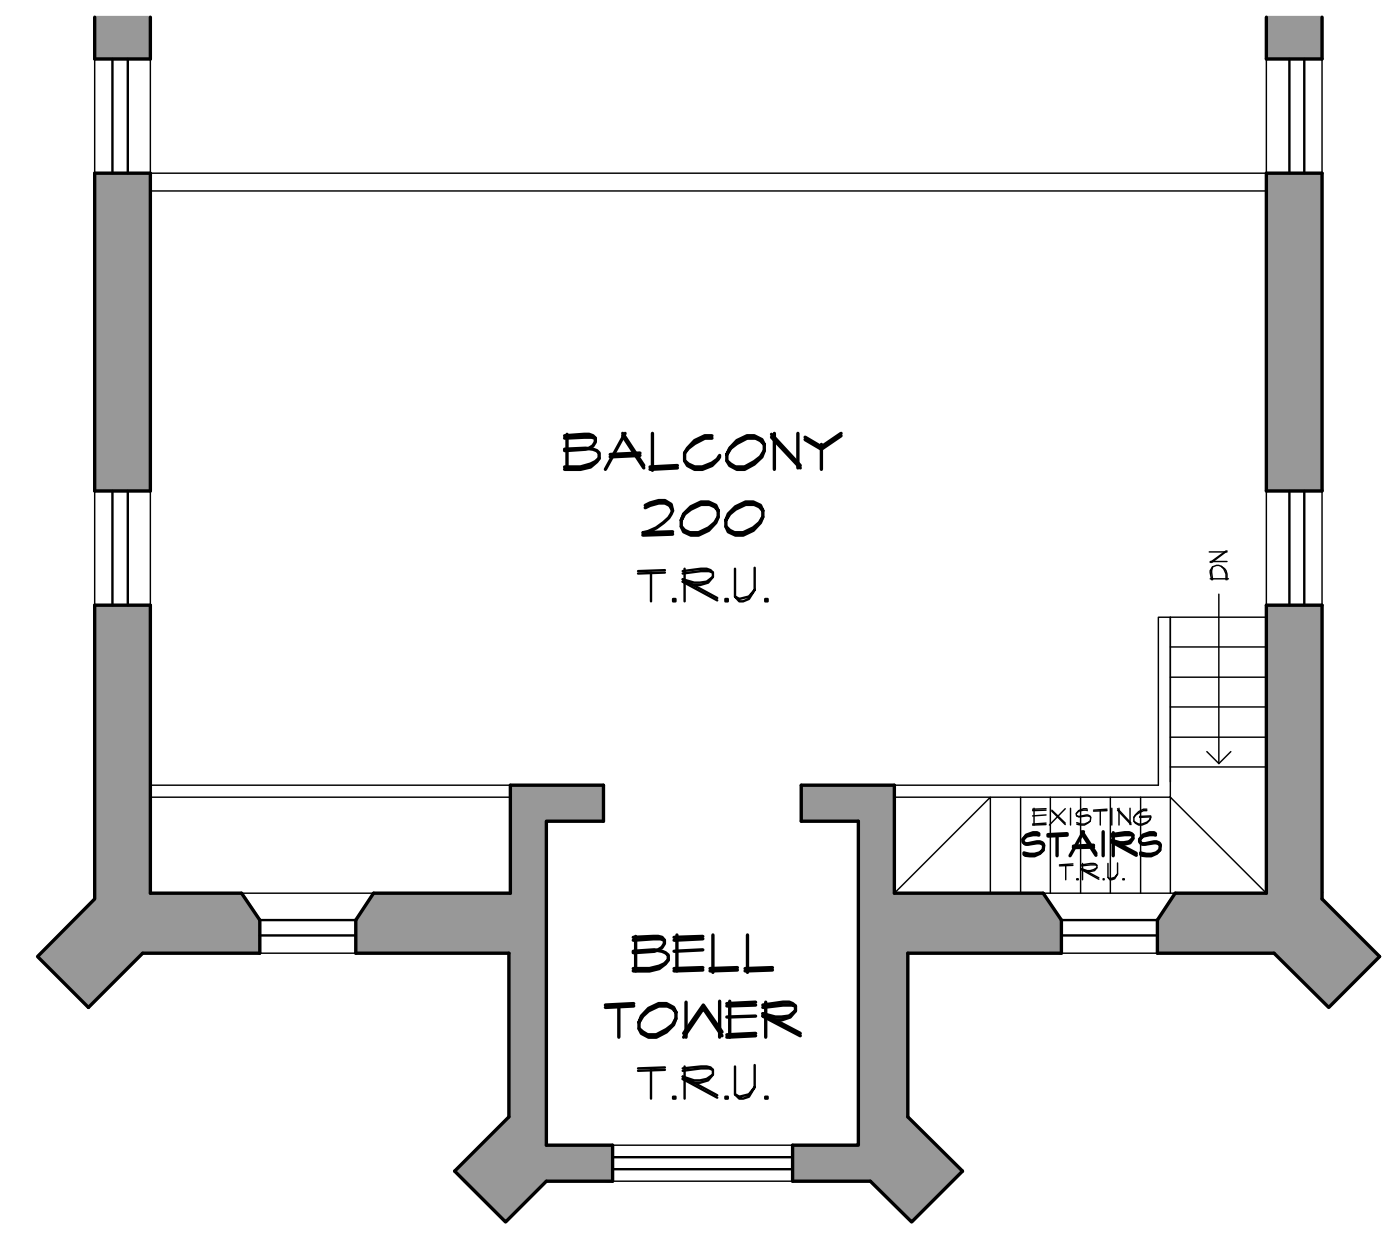

EXIST BALCONY PLAN
 3/16" = 1'-0"
 NO RENOVATION
 TRU = TO REMAIN UNCHANGED
 CHECK FINISH SCHEDULE FOR ANY FINISH CHANGES

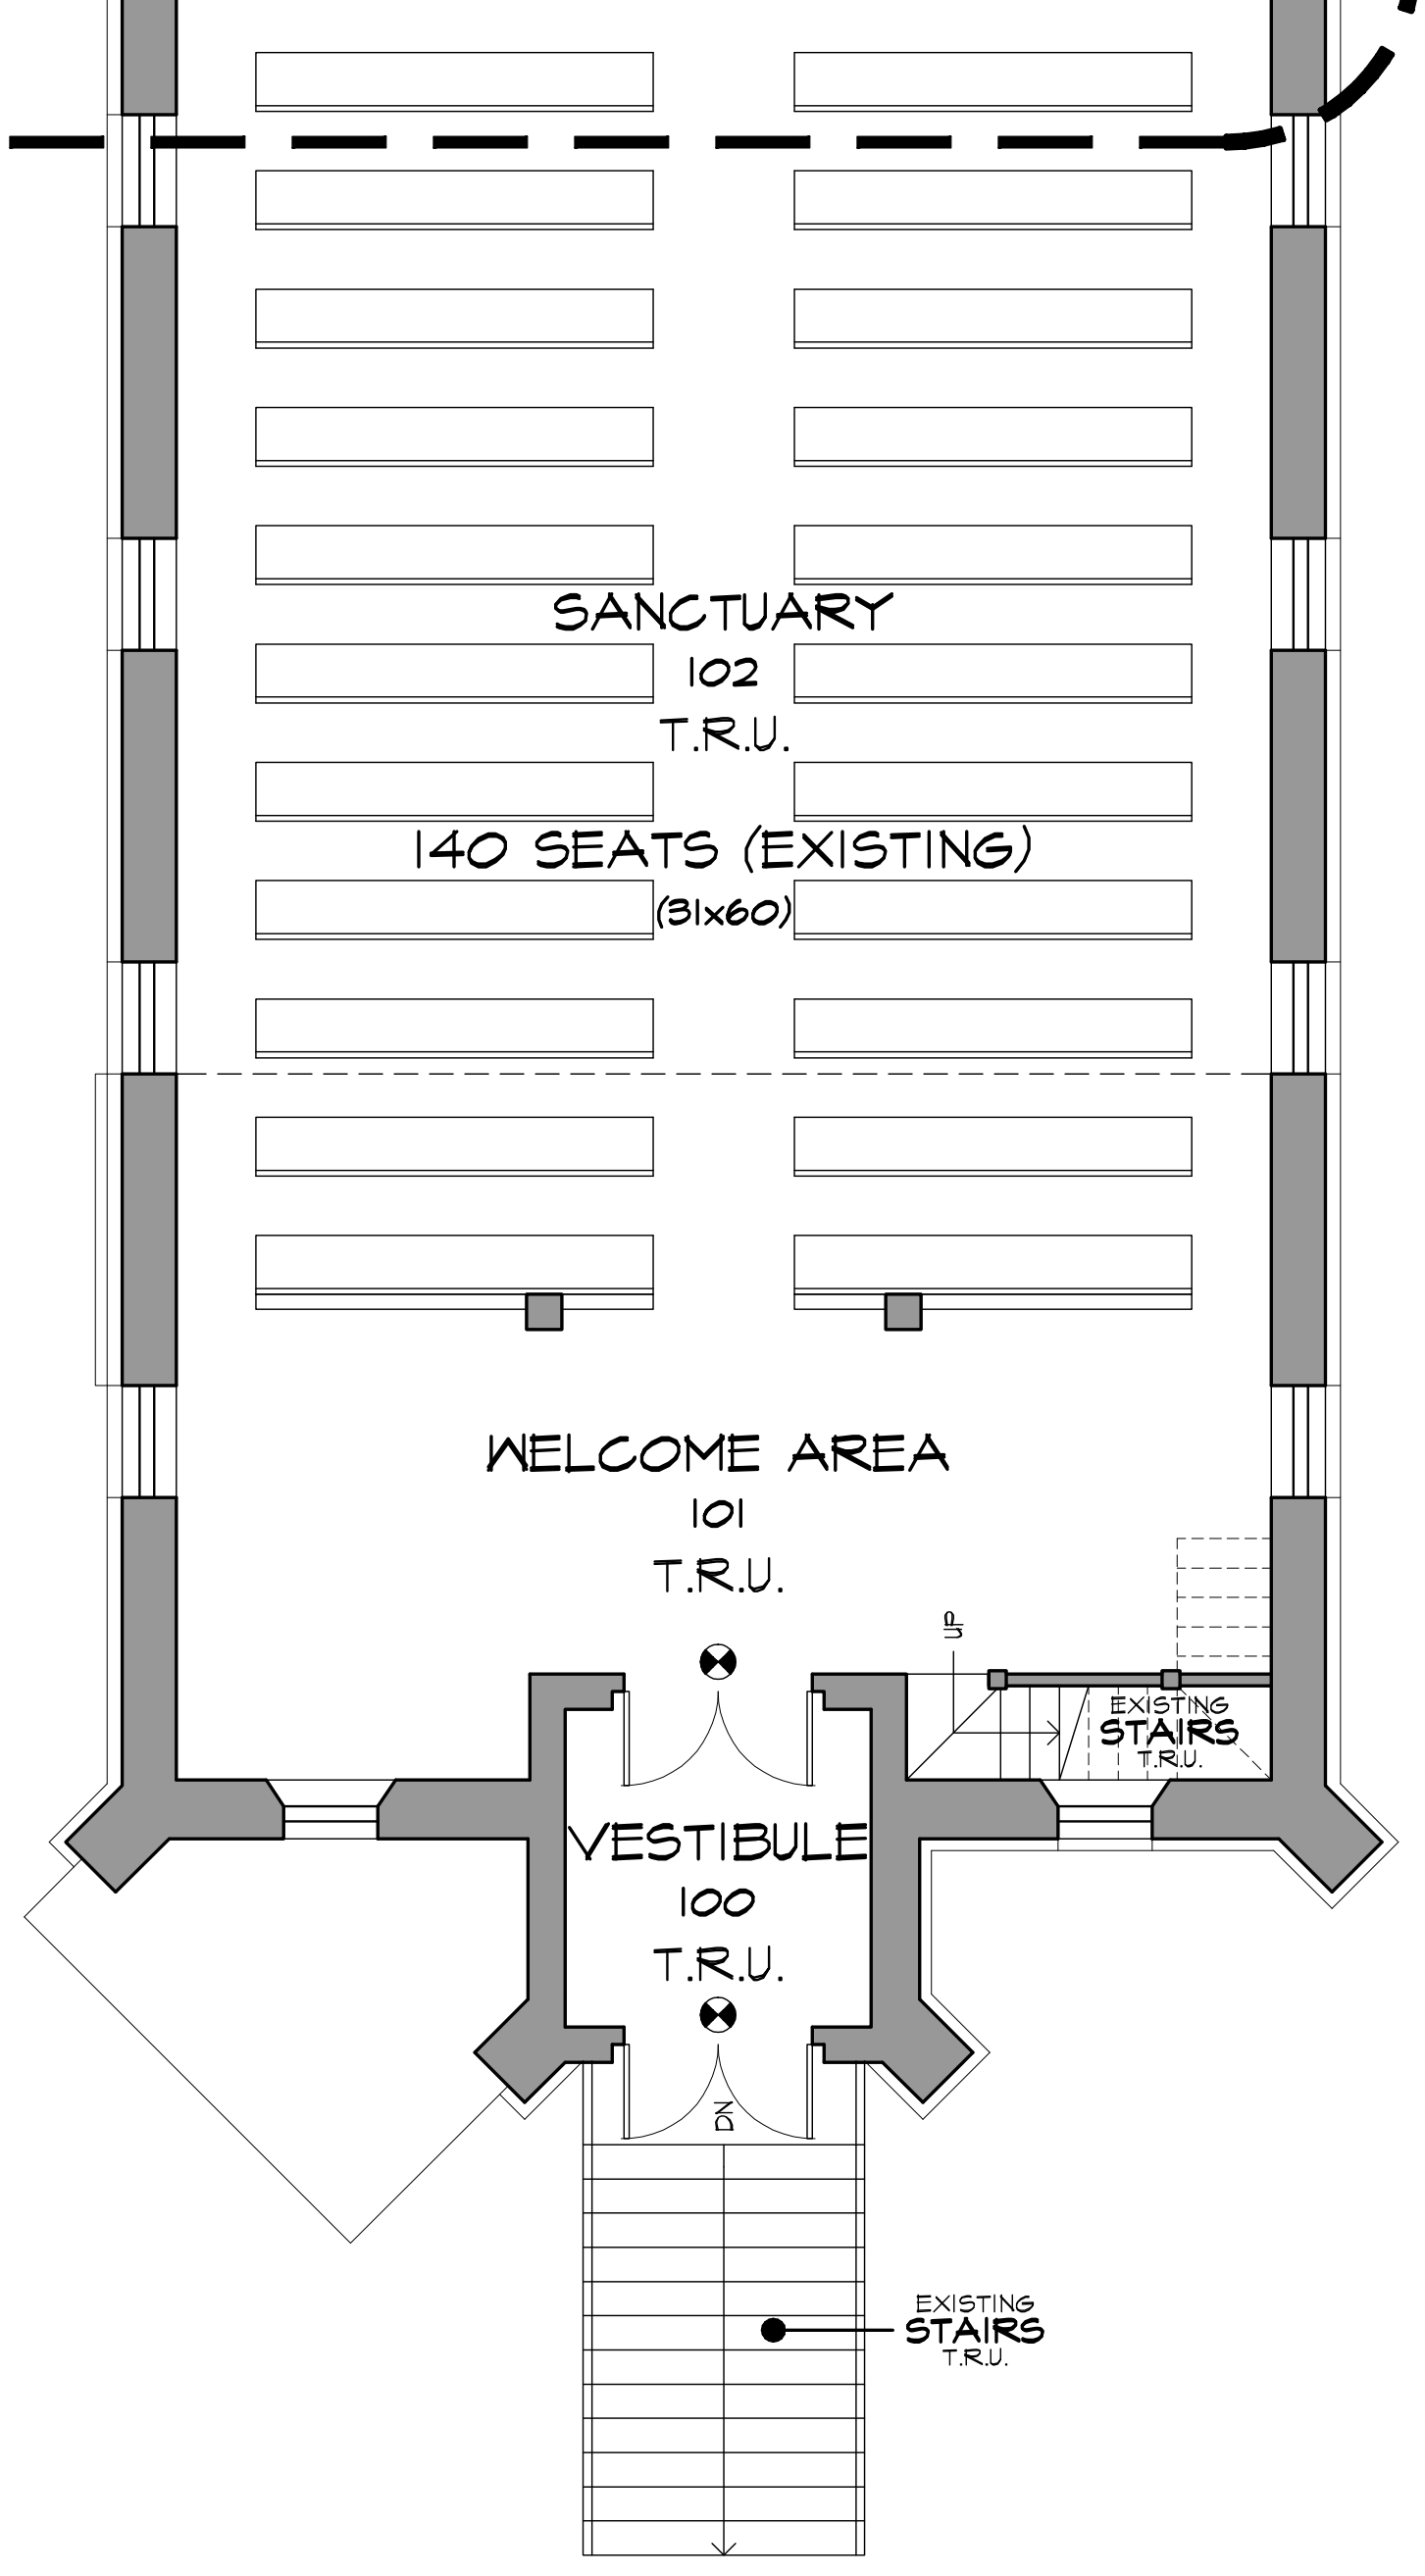

RICHARD F. STELDT & ASSOCIATES, LTD. ARCHITECTS
 502-4500
 190 W16890 ROOSEVELT DR. #8, MENOMONEE FALLS, WI 53051

Drawn: AAP
 Approved:

date	comments
REVISIONS	
Job: 2430-621	
Date: 9-10-21	

DISCLAIMER OF DOCUMENT: This document, and the ideas and designs incorporated herein, is an instrument of professional service, is the property of Richard F. Steldt and Associates, Ltd. and is not to be used in whole or in part for any other project without the written authorization of Richard F. Steldt and Associates, Ltd.

agape COMMUNITY CHURCH





Sheet
A-2



SEE PLANS ON THIS SHEET FOR DEMOLITION AND RENOVATION IN THIS AREA

GENERAL FLOOR PLAN NOTES :

1. ALL WALLS / DOORS ARE NEW - SEE SHEET A-4 FOR TYPE
2. ALL FIXTURES / MILLWORK ARE NEW
3. SEE SHEET A-4 FOR ALL FINISHES

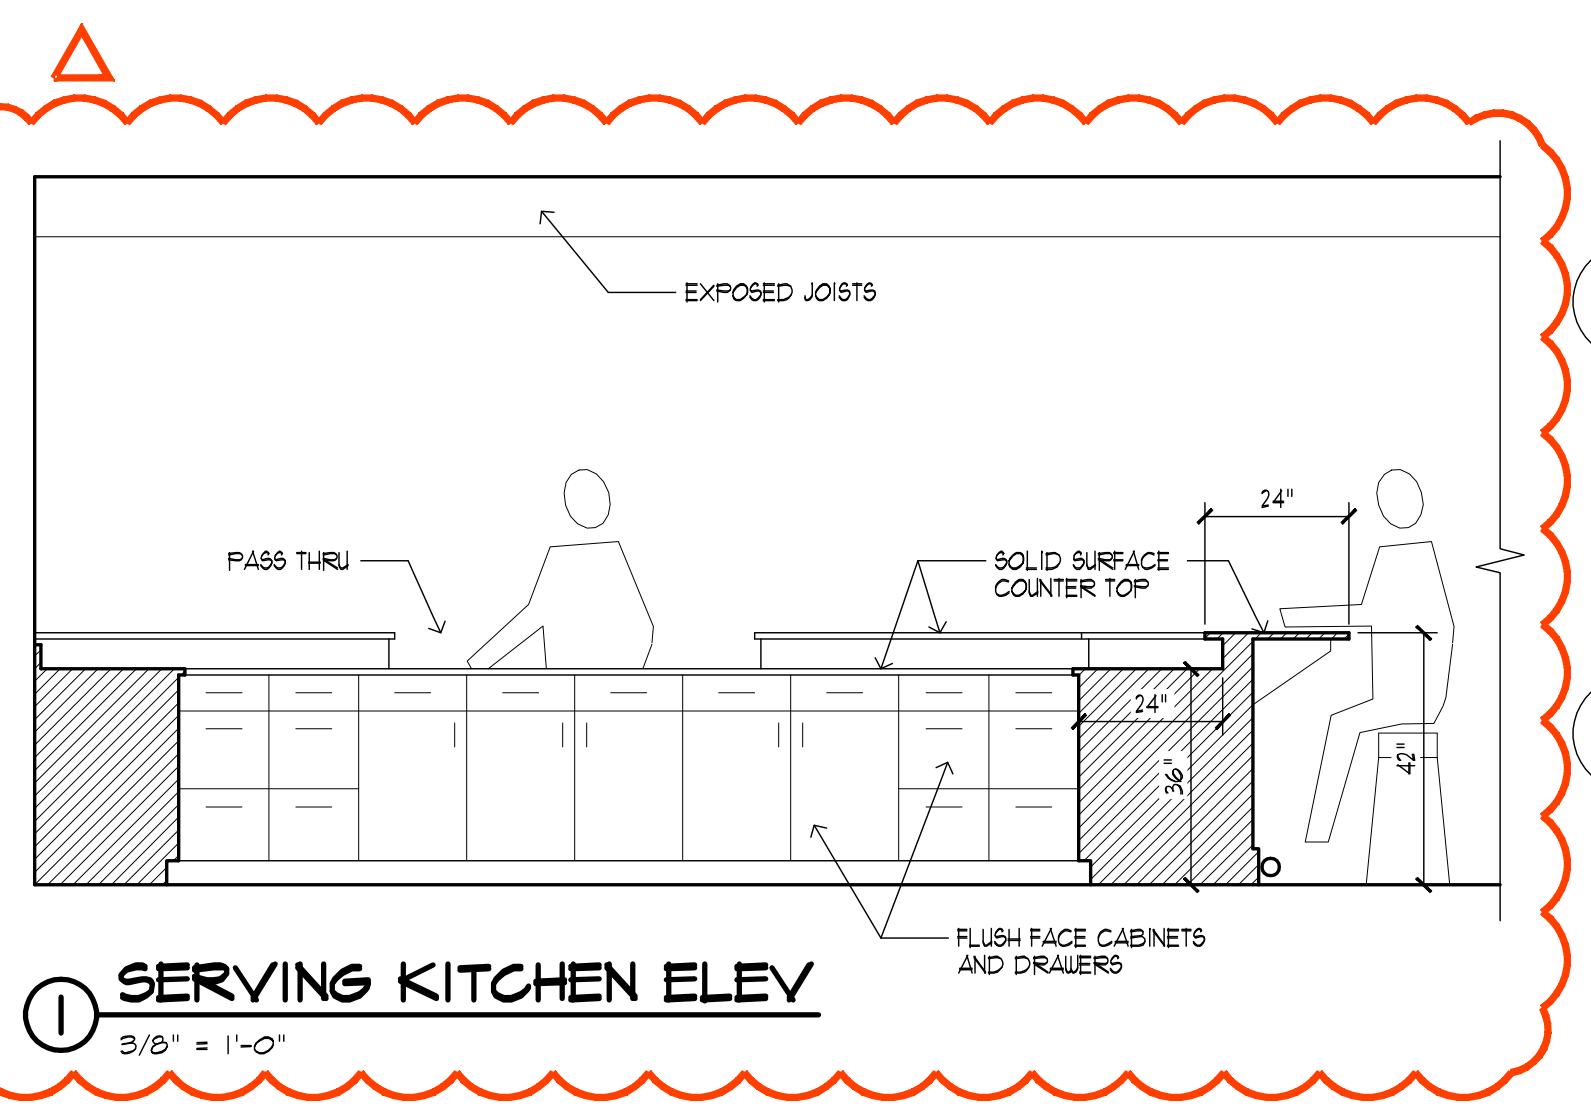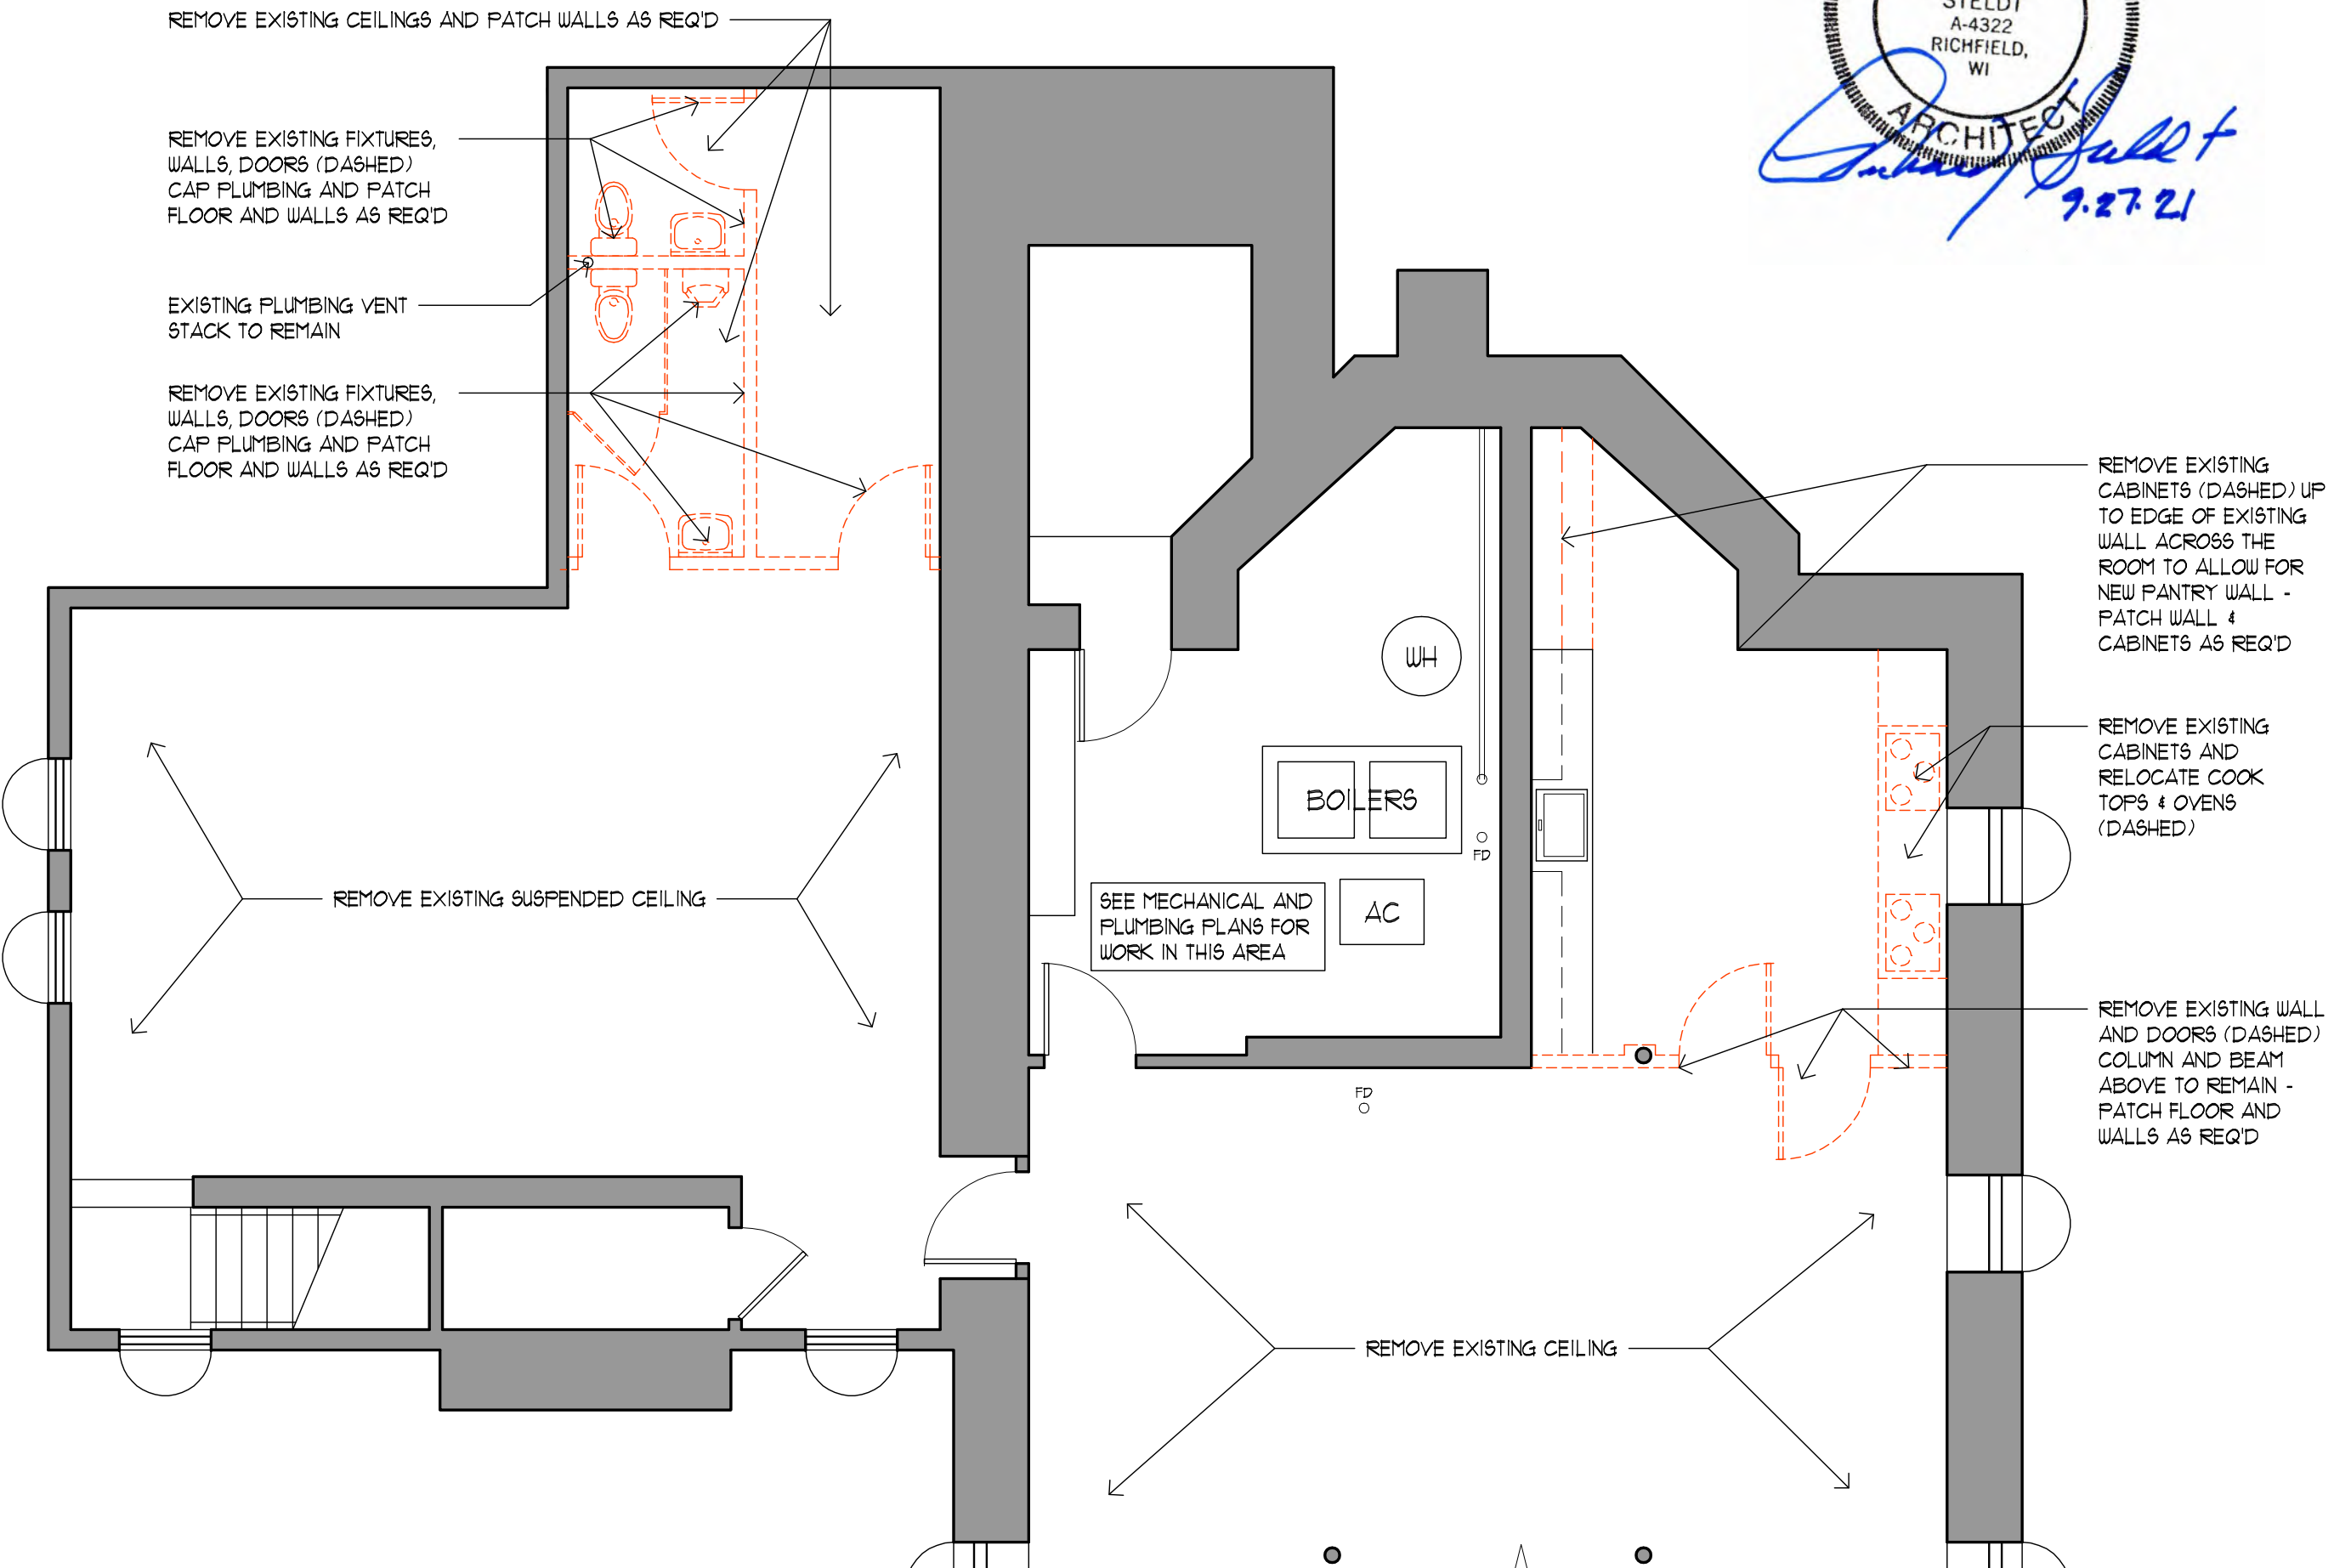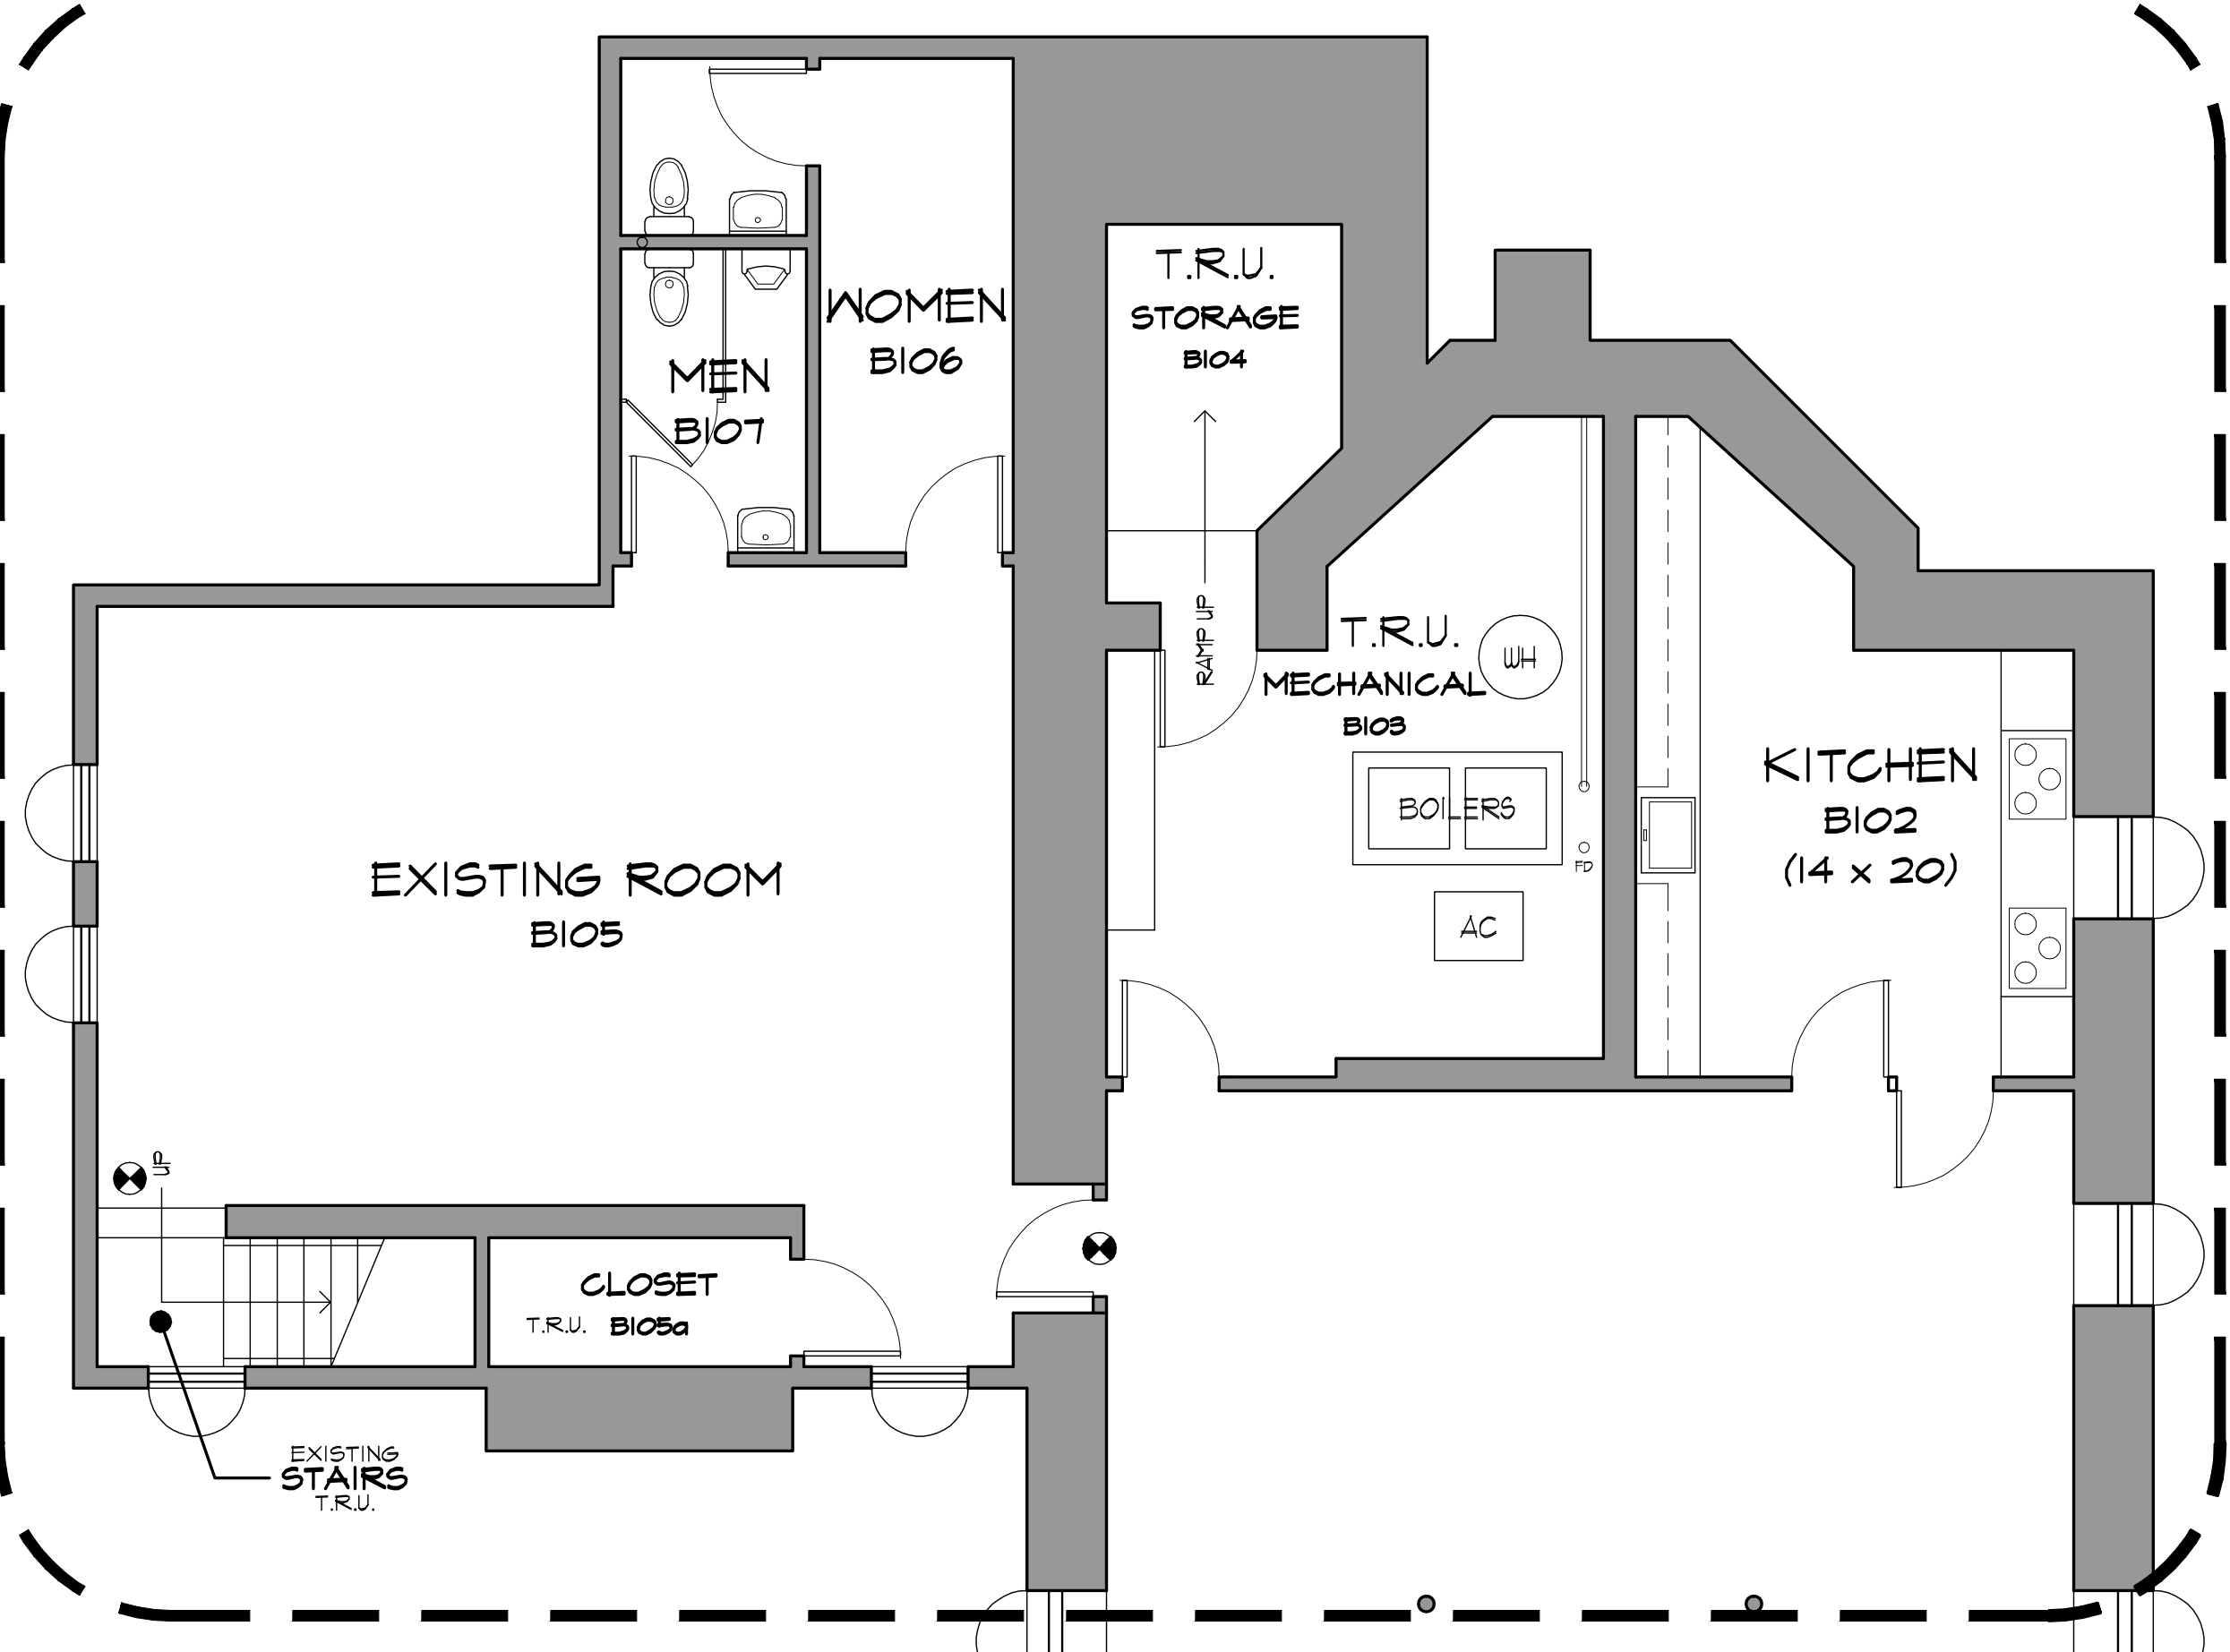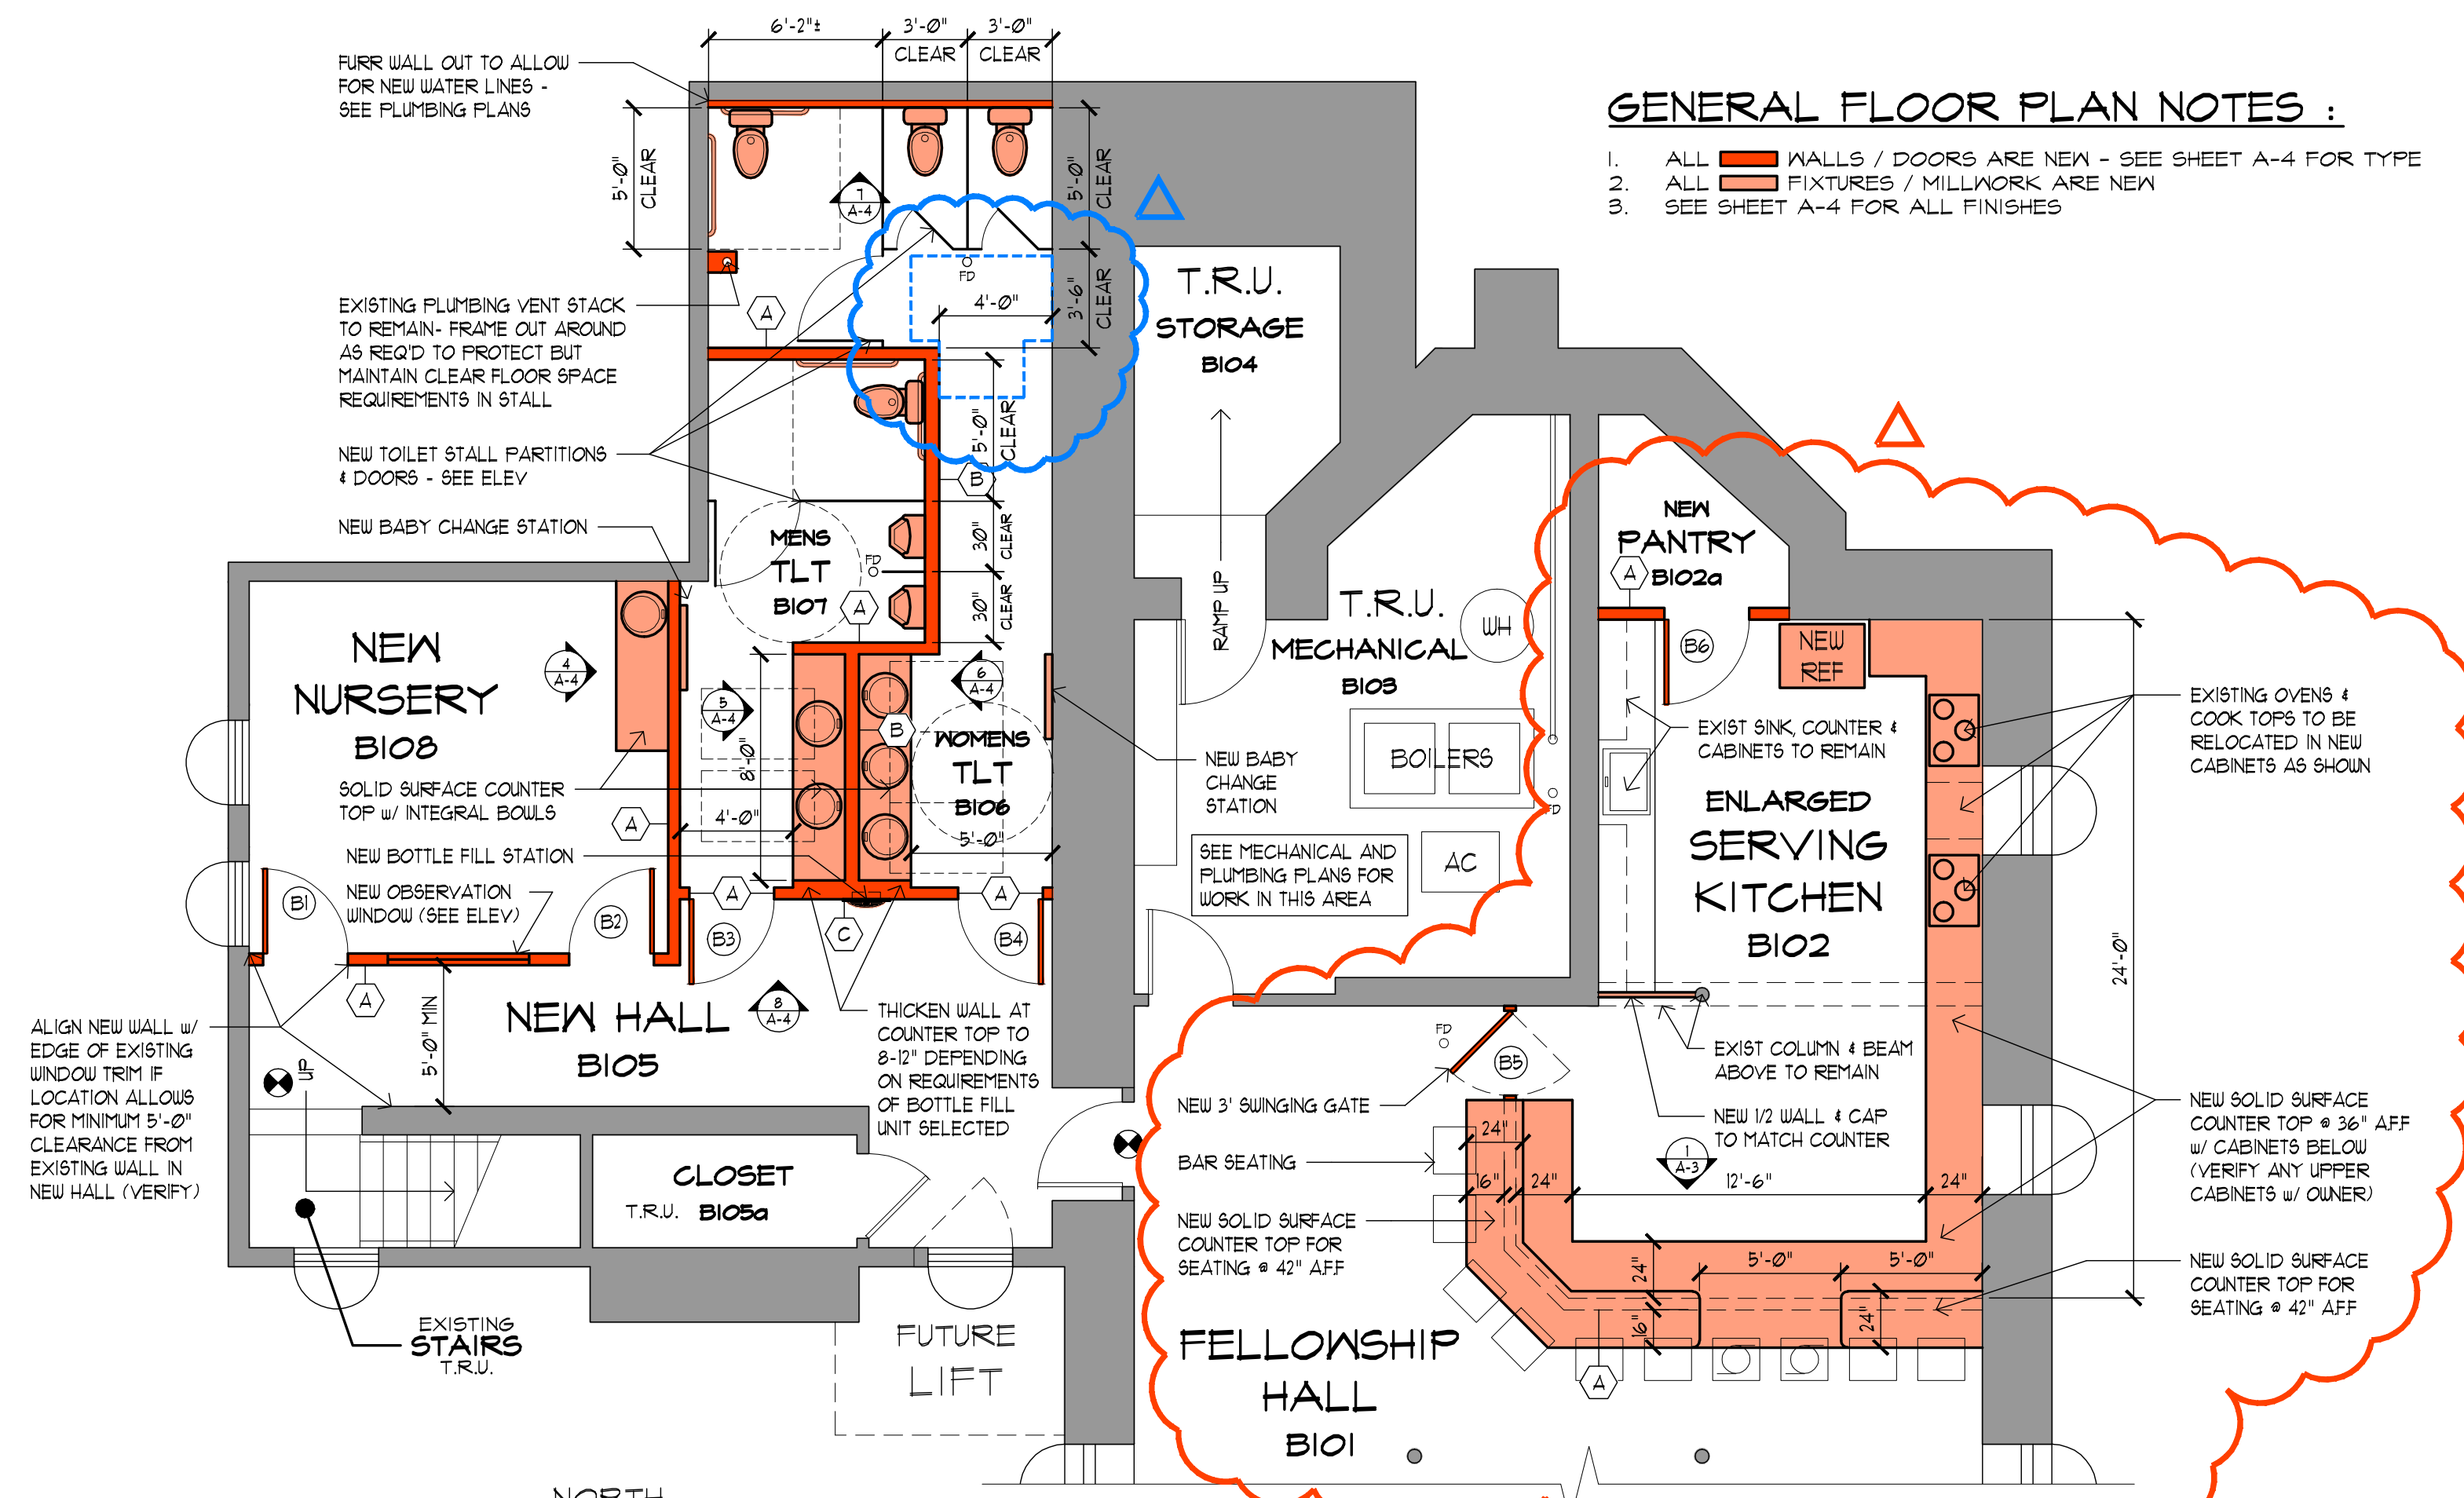

PLAN CONDITIONALLY APPROVED
 No Variation of this Plan is Permitted without the Approval of E-Plan Exam and the Municipal Building Inspection Department. See Plan Review Letter and/or Permit for additional conditions that must be addressed during construction prior to inspection.
 Municipality: Village of Pewaukee
 Approved By: John J. Cunningham Date: 09/27/2021

RICHARD F. STELDT & ASSOCIATES, LTD. ARCHITECTS
 502-4500
 502-4500
 1800 ROOSEVELT DR. #8, MENOMONEE FALLS, WI 53051


Drawn: AAP
 Approved:

date	comments
09-21-2021	REVISED KITCHEN DESIGN
09-20-2021	REVISED FOR REVIEW


REVISIONS
 Job: 2430-621
 Date: 9-10-21

agape COMMUNITY CHURCH


Sheet
A-3

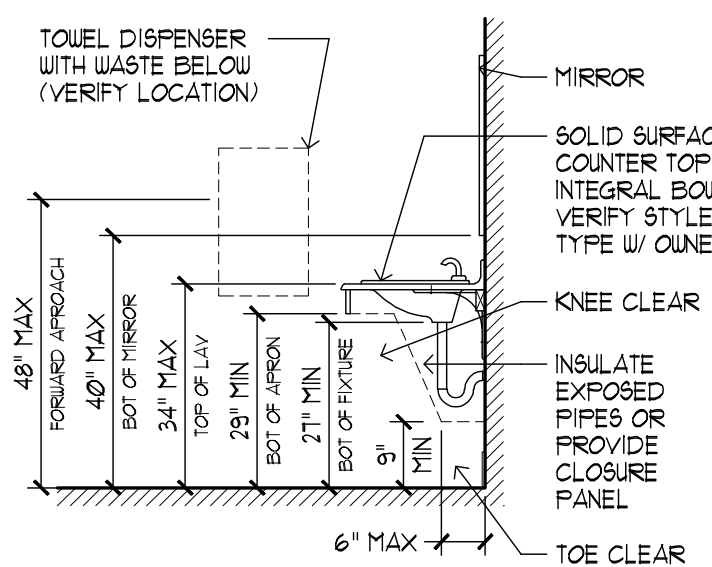


A SINK VANITY
3/8" = 1'-0"

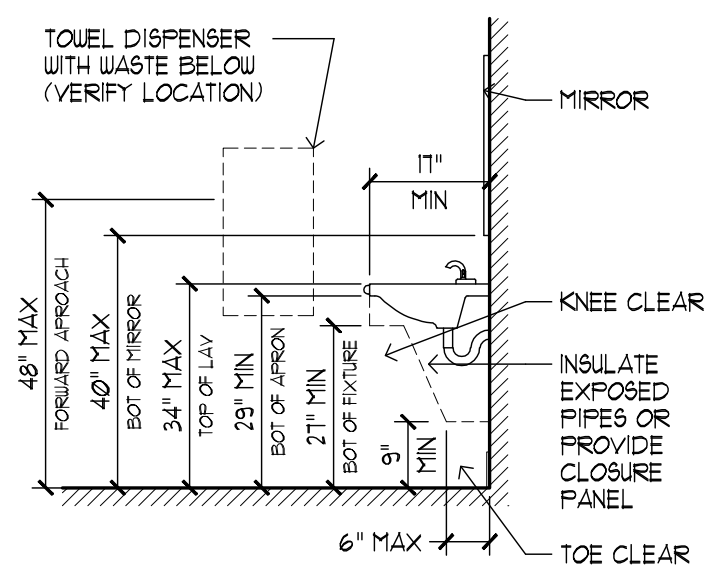


B SINK WALL HUNG
3/8" = 1'-0"

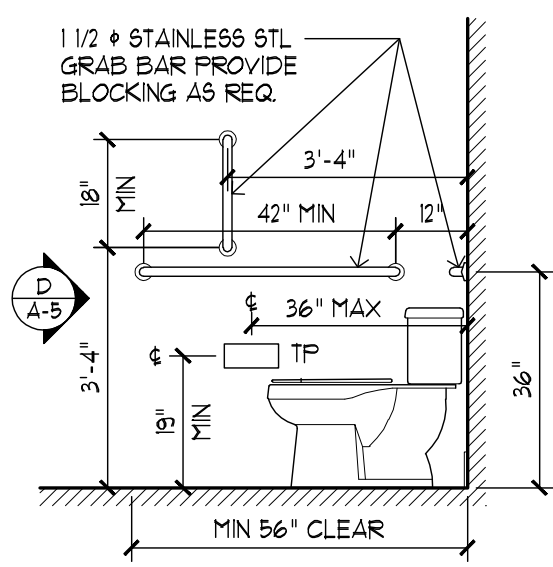


C TLT (SIDE)
3/8" = 1'-0"

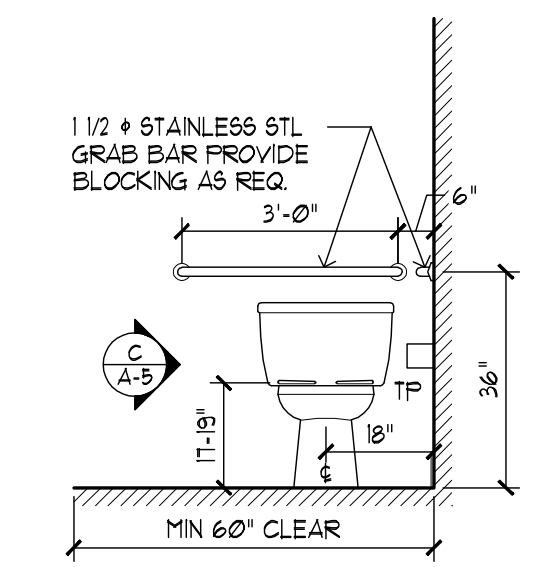


D TLT (FRONT)
3/8" = 1'-0"

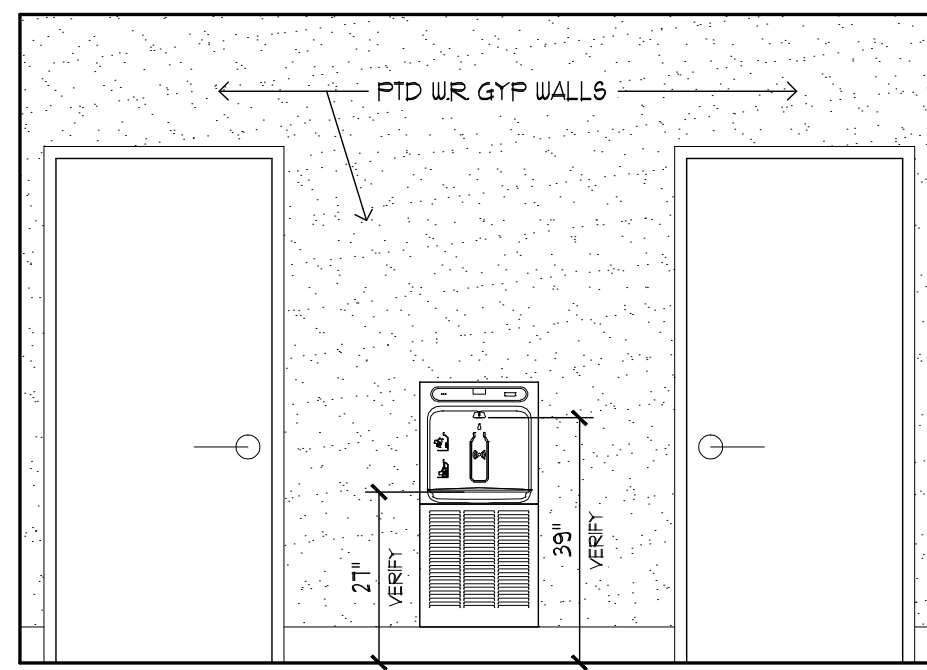


1 NEW HALL 109
3/8" = 1'-0"

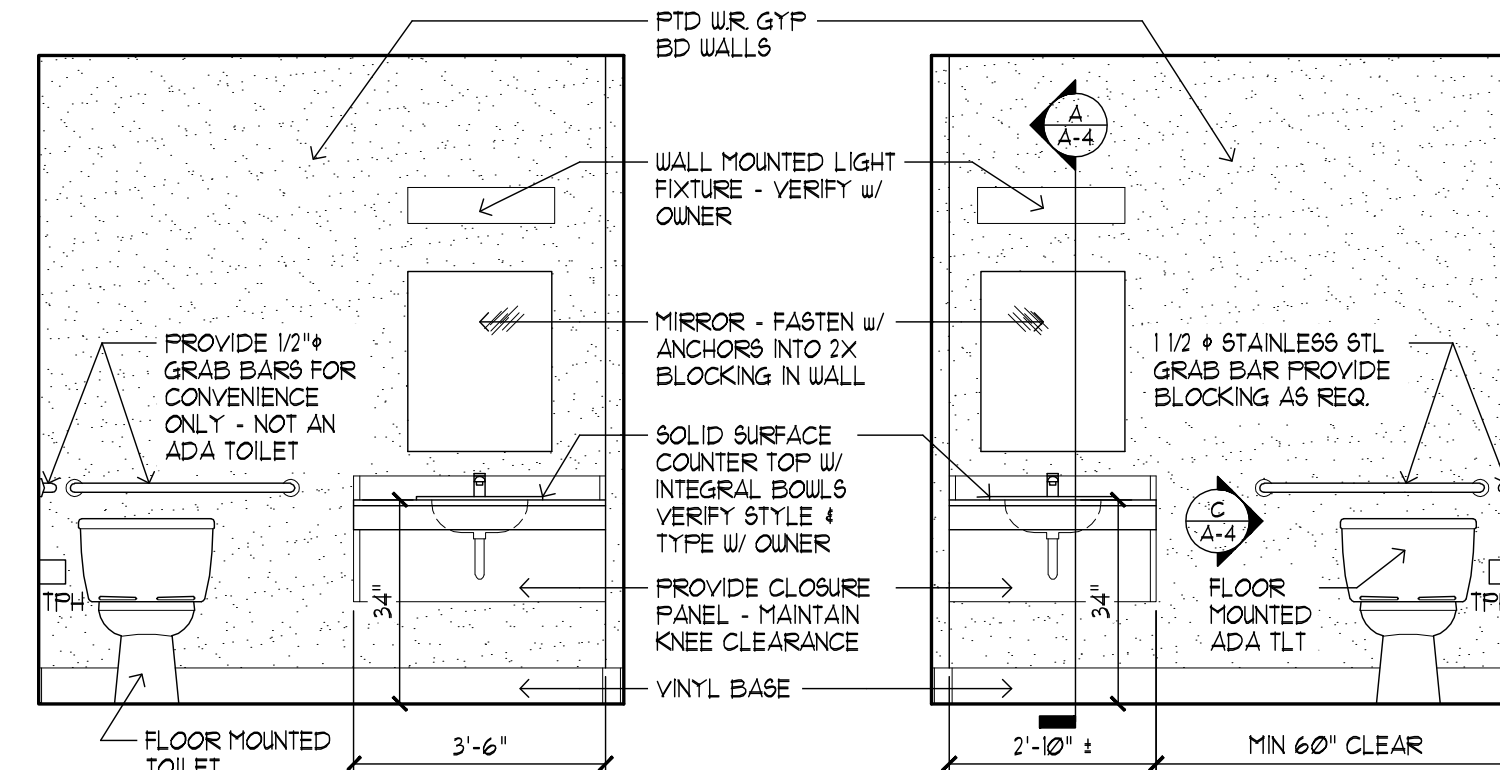


2 UNISEX TOILET III
3/8" = 1'-0"

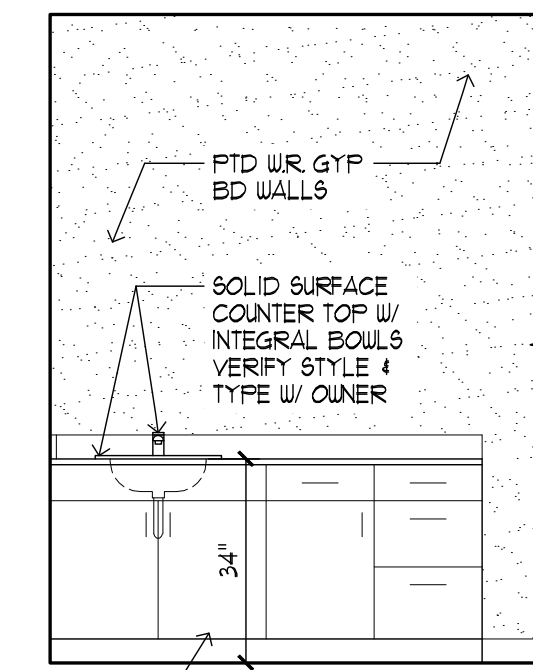


3 UNISEX ADA TLT II
3/8" = 1'-0"

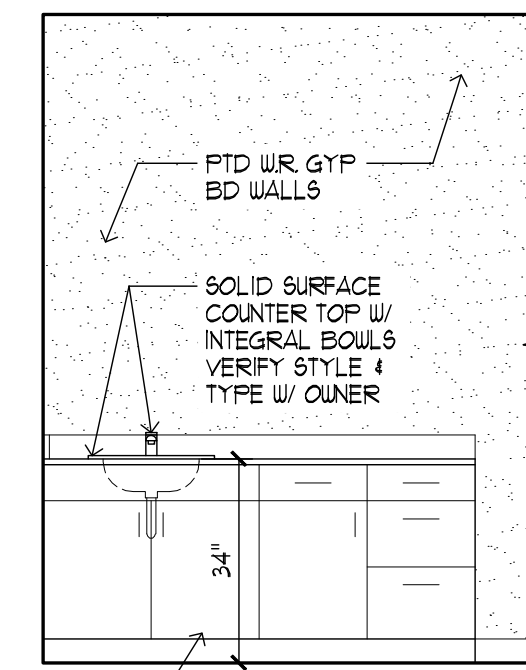


4 NURSERY
3/8" = 1'-0"

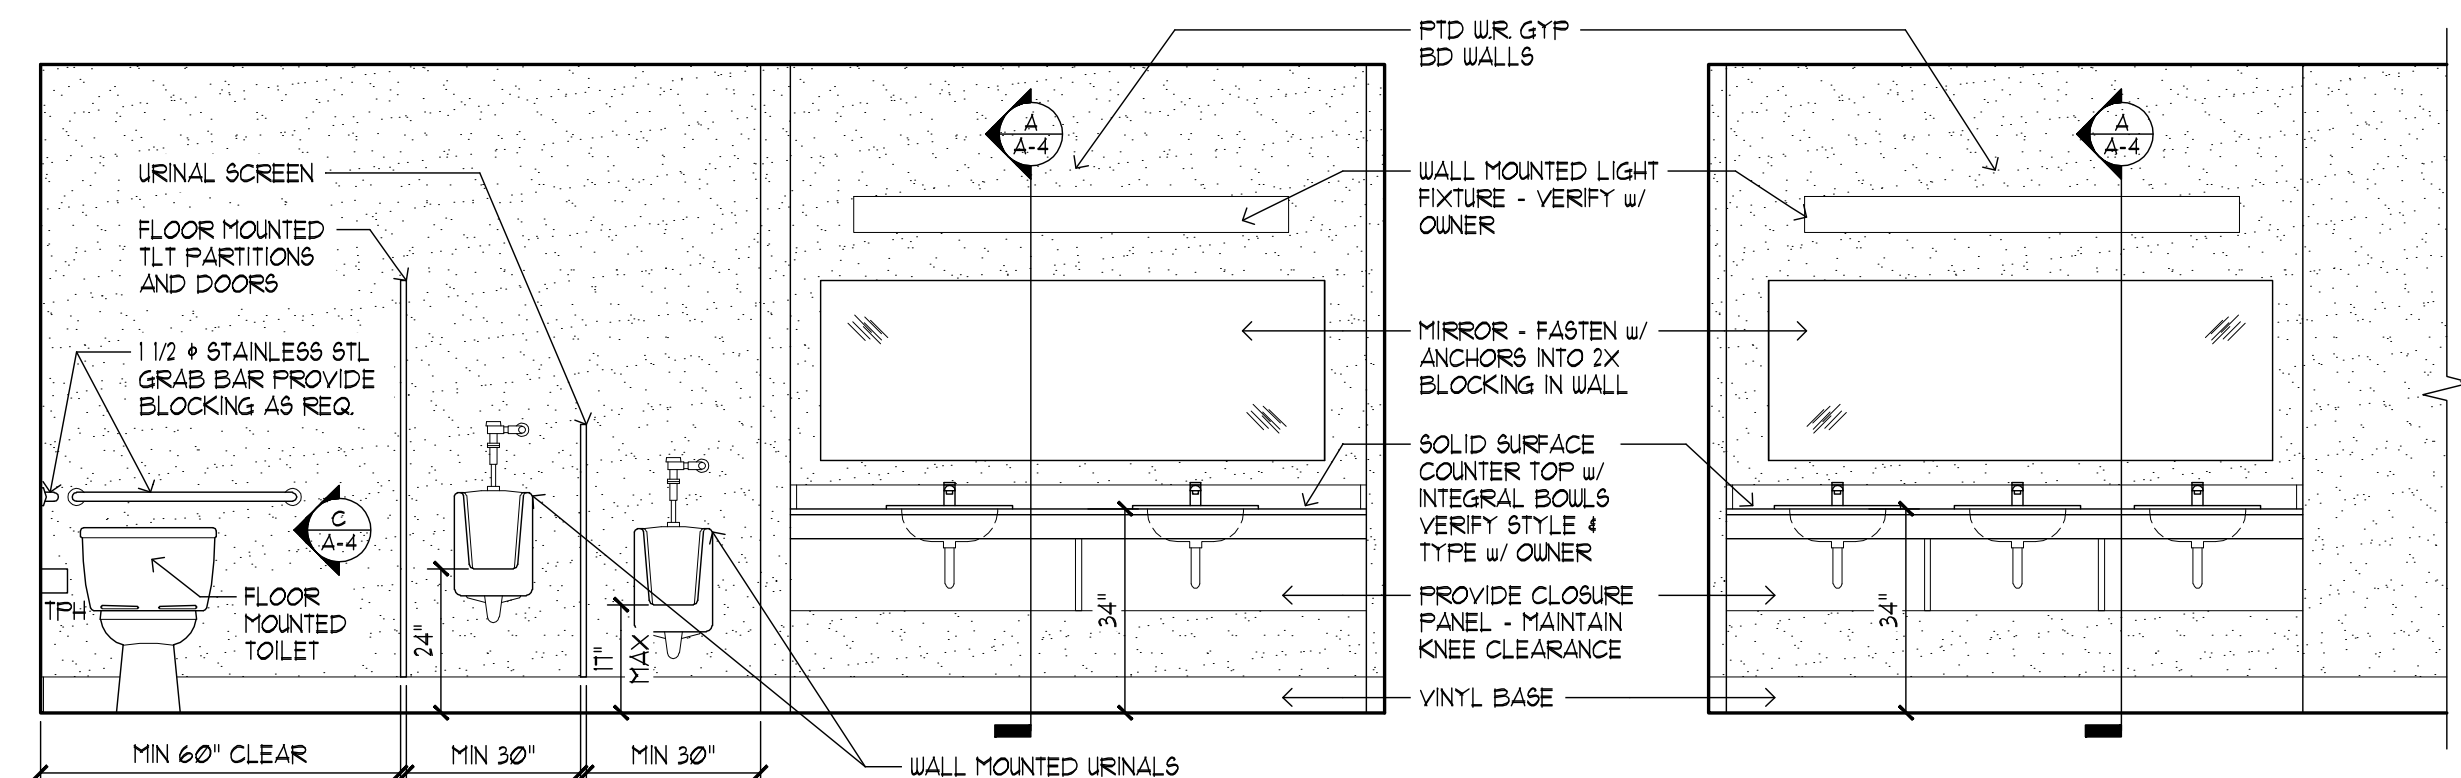


5 MENS TOILET B107
3/8" = 1'-0"

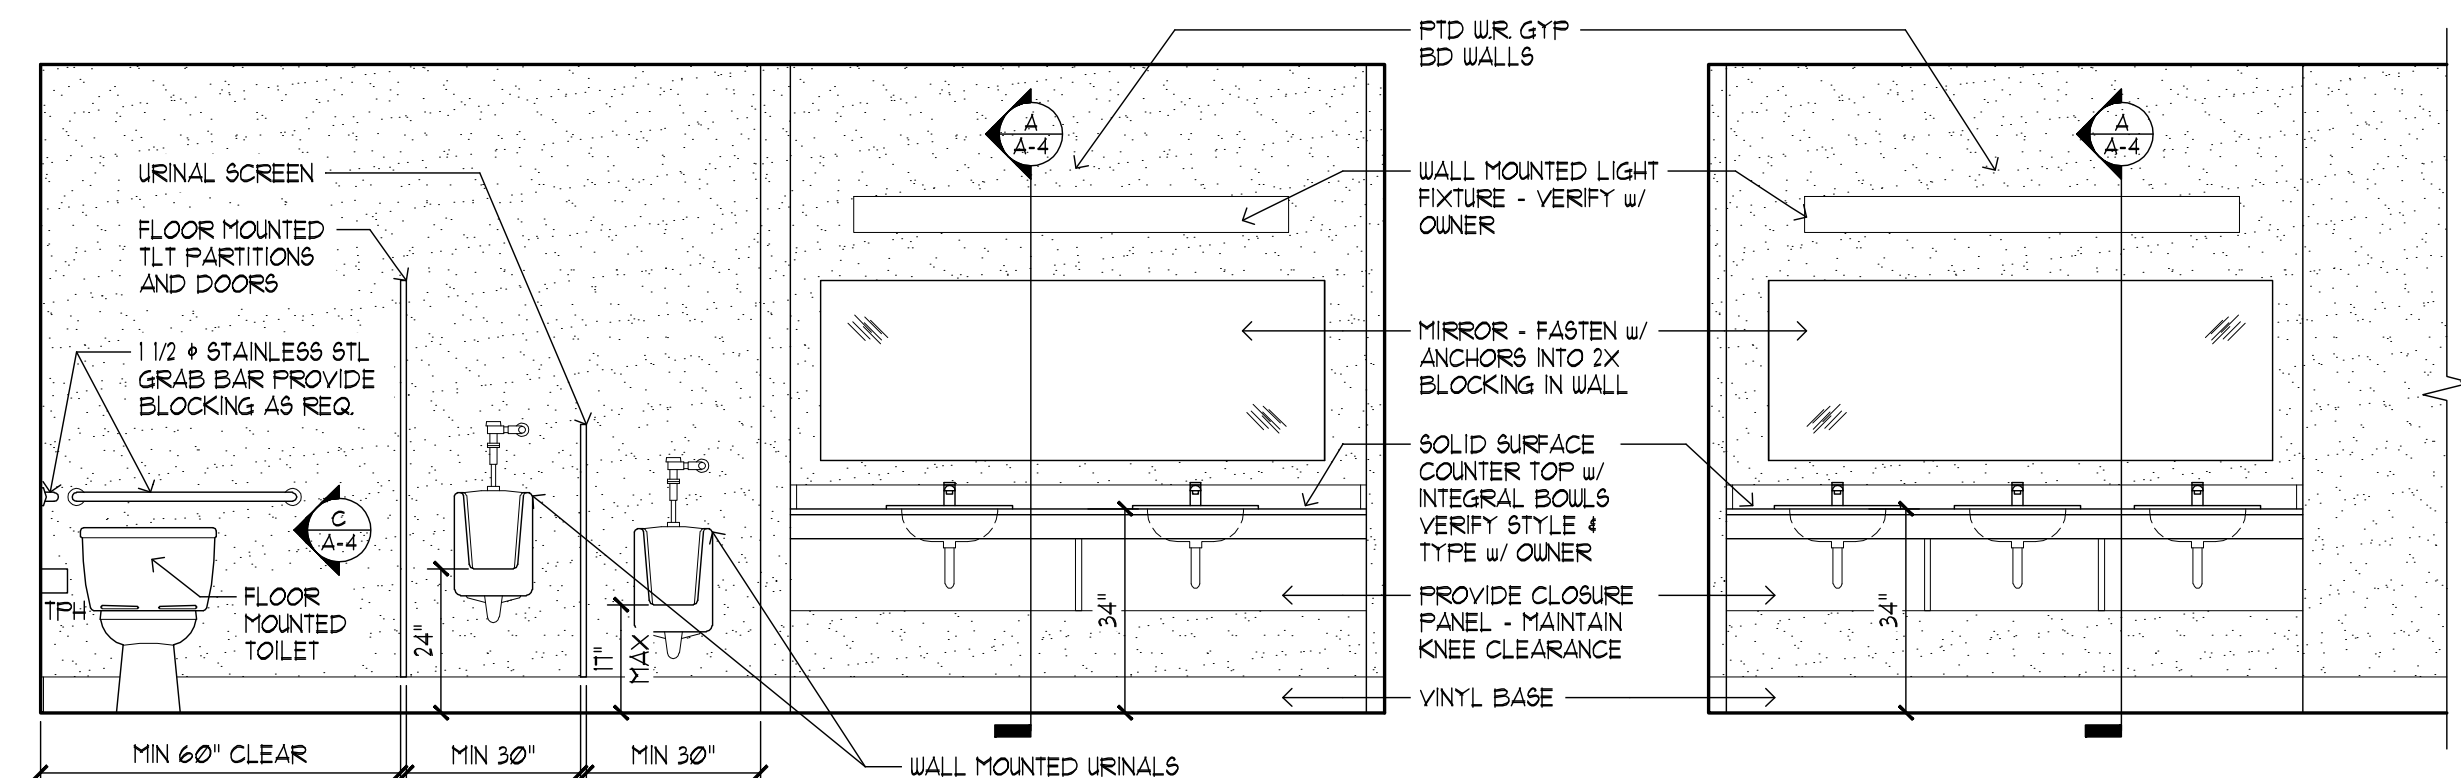

6 WOMENS TOILET B106
3/8" = 1'-0"

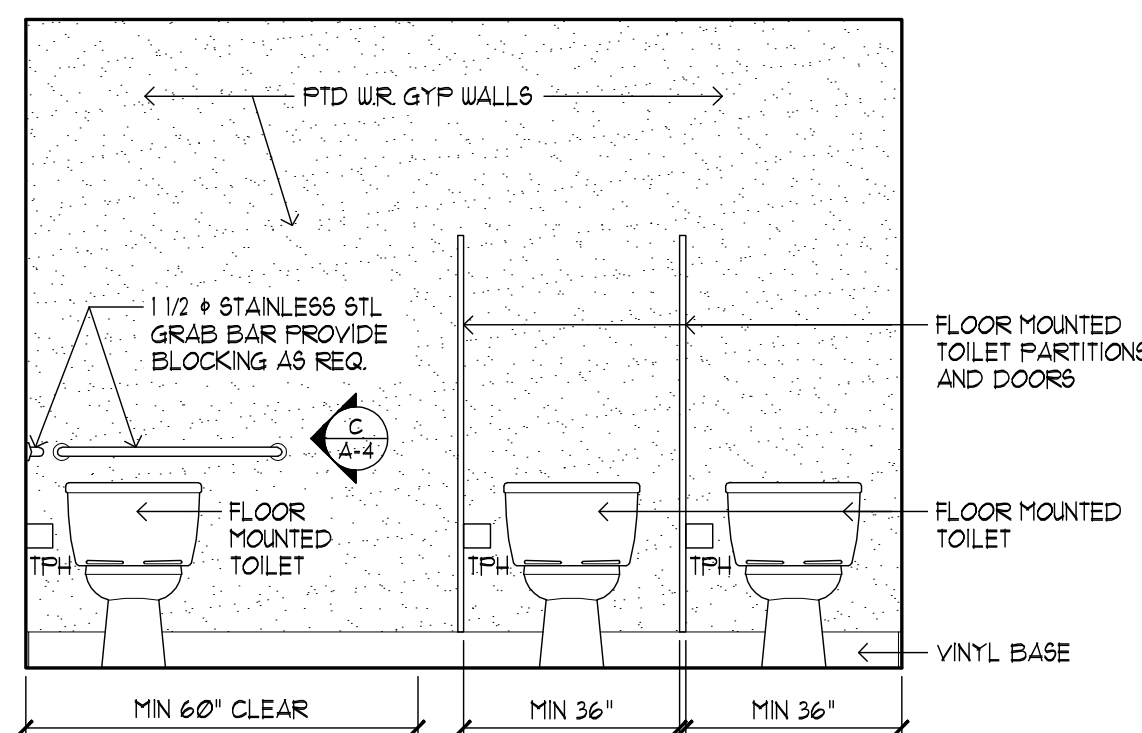

7 WOMENS TOILET B106
3/8" = 1'-0"

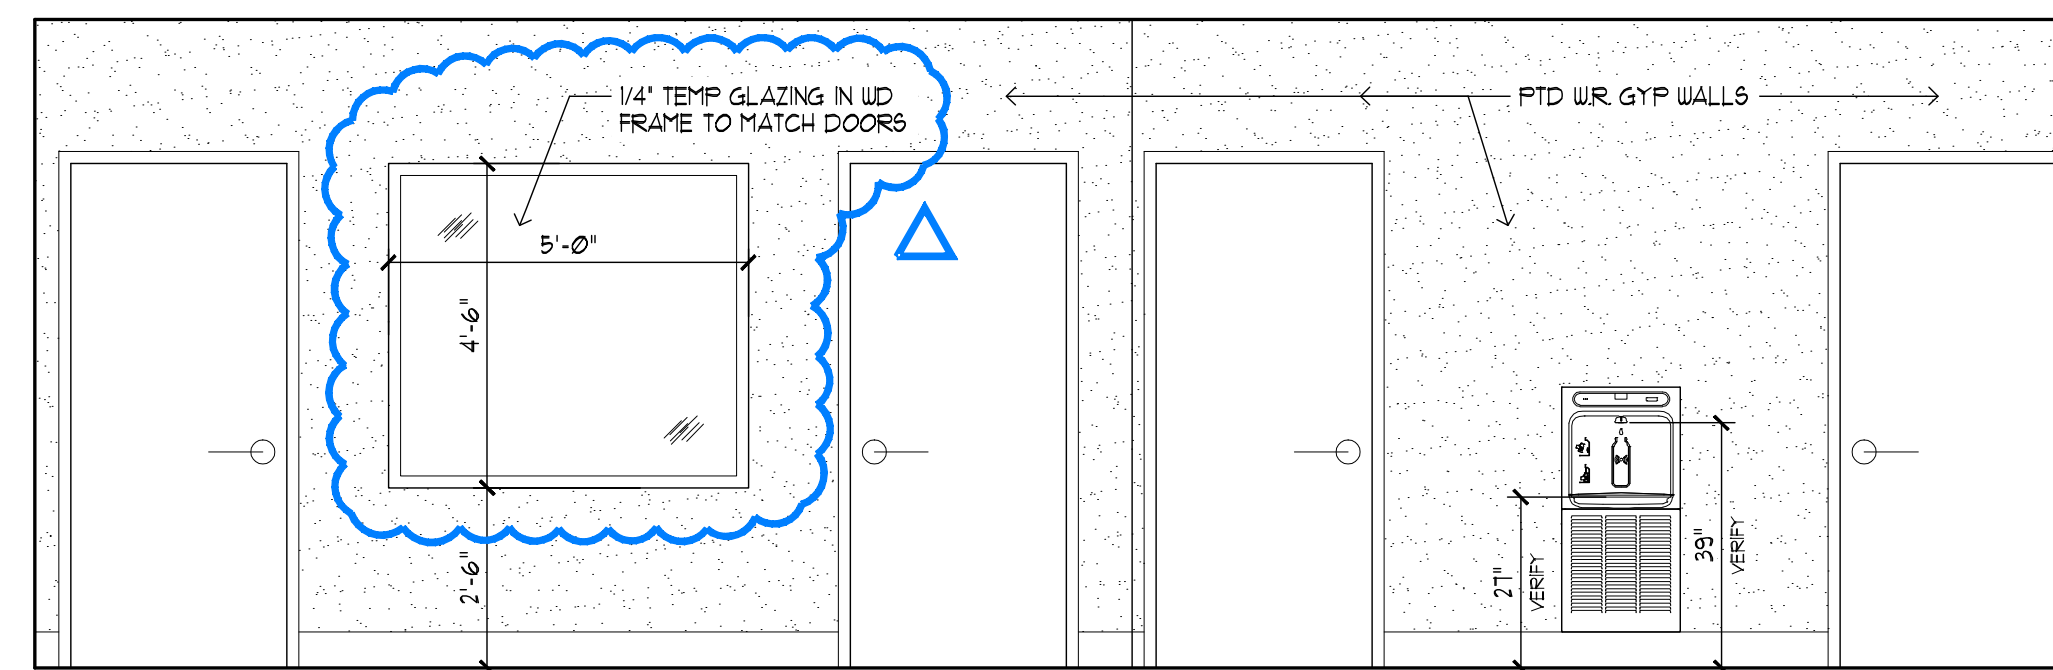


8 NEW HALLWAY B105
3/8" = 1'-0"

DOOR SCHEDULE

DR#	LOCATION	SIZE	TYPE	MATERIAL	FRAME	GLAZING	REMARKS
FIRST FLOOR & BALCONY							
1	NEW CLOSET 105a TO HALL 105	(2) 3'-0" x 6'-8"	B	PAINTED SOLID CORE WOOD	WOOD	-	-
2	HALL 105 TO QUIET ROOM 106	3'-0" x 6'-8"	A	PAINTED SOLID CORE WOOD	WOOD	VISION LITE	-
3	NEW HALL 109 TO UNISEX ADA TLT II	3'-0" x 6'-8"	A	PAINTED SOLID CORE WOOD	WOOD	-	-
4	NEW HALL 109 TO UNISEX TLT III	3'-0" x 6'-8"	A	PAINTED SOLID CORE WOOD	WOOD	-	-
BASEMENT							
B1	NEW HALL B105 TO NURSERY B108	3'-0" x 6'-8"	A	PAINTED SOLID CORE WOOD	WOOD	VISION LITE	-
B2	NEW HALL B105 TO NURSERY B108	3'-0" x 6'-8"	A	PAINTED SOLID CORE WOOD	WOOD	VISION LITE	-
B3	MENS TOILET B107 TO NEW HALL B105	3'-0" x 6'-8"	A	PAINTED SOLID CORE WOOD	WOOD	-	-
B4	WOMENS TOILET B106 TO NEW HALL B105	3'-0" x 6'-8"	A	PAINTED SOLID CORE WOOD	WOOD	-	-
B5	SERV KIT B102 TO FELLOWSHIP HALL B101	3'-6" x 6'-8"	A	PAINTED SOLID CORE WOOD	WOOD	VISION LITE	-
B6	NEW PANTRY 102a TO SERV KITCHEN B102	3'-0" x 6'-8"	A	PAINTED SOLID CORE WOOD	WOOD	-	-

VERIFY ALL DOOR STYLES & HARDWARE WITH OWNER


DOOR TYPES

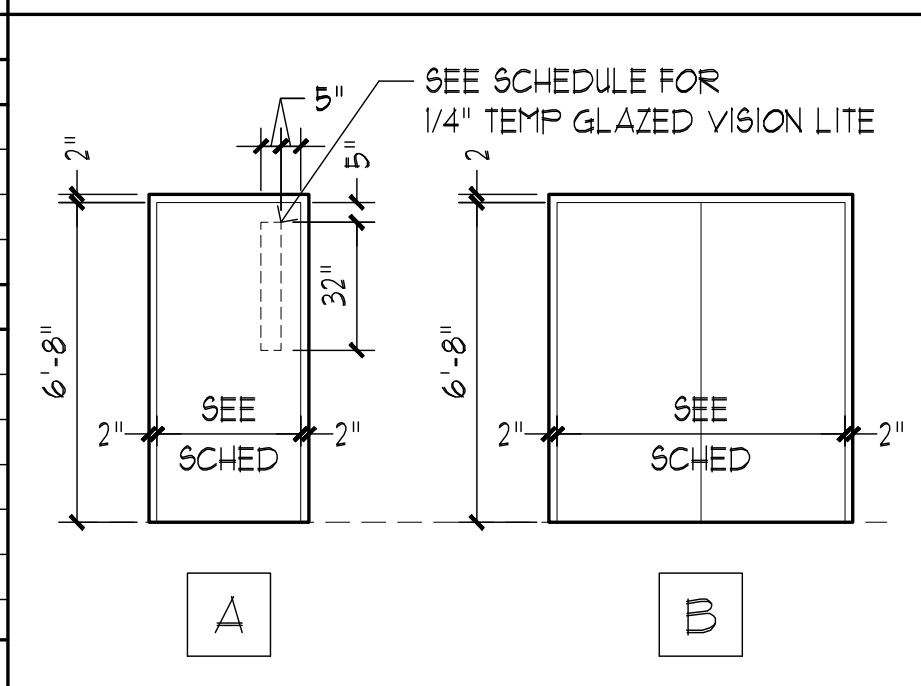

FINISH SCHEDULE


R#	ROOM NAME	FLOOR	BASE	WALLS	CEILING	CLG HGT	REMARKS
FIRST FLOOR & BALCONY							
100	EXIST VESTIBULE	LUX VINYL OR PLANK	VINYL	EXISTING PLASTER	EXIST PLASTER	EXISTING	-
101	EXIST WELCOME AREA	LUX VINYL OR PLANK	VINYL	EXISTING PLASTER	EXIST PLASTER	EXISTING	-
102	EXIST SANCTUARY	LUX VINYL OR PLANK	VINYL	EXISTING PLASTER	EXIST PLASTER	EXISTING	-
103	EXIST STORAGE	CARPET SQUARES		EXISTING PLASTER	EXIST PLASTER	EXISTING	-
104	EXIST PLATFORM	CARPET SQUARES		EXISTING PLASTER	EXIST PLASTER	EXISTING	-
105	HALLWAY	LUX VINYL OR PLANK	VINYL	EXIST PLASTER & NEW PTD GYP BD	EXIST PLASTER	EXISTING	-
105a	NEW HALL CLOSET	LUX VINYL OR PLANK	VINYL	EXIST PLASTER & NEW PTD GYP BD	EXIST PLASTER	EXISTING	-
106	ENTRY & RAMP	LUX VINYL OR PLANK	VINYL	EXIST PLASTER & NEW PTD GYP BD	EXIST PLASTER	EXISTING	-
107	MULTI-PURPOSE ROOM	REFINISH EXIST WD	EXIST	EXISTING PLASTER	EXIST PLASTER	EXISTING	-
108	RAMP	LUX VINYL OR PLANK	MATCH	PTD GYP BD TO MATCH	EXIST PLASTER	EXISTING	-
108	QUIET ROOM	REFINISH EXIST WD	EXIST	EXIST PLASTER & STONE	EXIST PLASTER	EXISTING	-
109	HALLWAY	LUX VINYL OR PLANK	VINYL	EXISTING PLASTER	PTD GYP BD	EXISTING	-
110	UNISEX ADA TOILET	LUX VINYL OR PLANK	VINYL	PTD UR. GYP BD	PTD UR. GYP BD	9'-0"	-
111	UNISEX TOILET	LUX VINYL OR PLANK	VINYL	PTD UR. GYP BD	PTD UR. GYP BD	9'-0"	-
200	BALCONY & STAIR	CARPET SQUARES		EXISTING PLASTER	EXIST PLASTER	EXISTING	-
BASEMENT							
B100	EXIST VESTIBULE	EXISTING	EXISTING	EXISTING PLASTER	EXIST PLASTER	EXISTING	-
B101	EXIST FELLOWSHIP HALL	LUX VINYL	VINYL	EXISTING PLASTER	PTD EXPOSED STRUCTURE	EXISTING	-
B102	SERVING KITCHEN	LUX VINYL	VINYL	EXIST PLASTER & NEW PTD GYP BD	EXIST & EXPOSED	EXISTING	-
B102a	PANTRY	LUX VINYL	VINYL	EXIST PLASTER & NEW PTD GYP BD	PTD GYP BD	EXISTING	-
B103	EXIST MECHANICAL	EXISTING	EXISTING	EXISTING	EXISTING	EXISTING	-
B104	EXIST STORAGE	EXISTING	EXISTING	EXISTING	EXISTING	EXISTING	-
B105	HALLWAY	LUX VINYL	VINYL	EXIST PLASTER & NEW PTD GYP BD	PTD EXPOSED STRUCTURE	EXISTING	-
B105a	EXIST CLOSET	LUX VINYL	VINYL	EXISTING PLASTER	EXIST PLASTER	EXISTING	-
B106	WOMENS ADA TOILET	LUX VINYL OR PLANK	VINYL	EXIST PLASTER & NEW PTD UR. GYP BD	PTD UR. GYP BD	9'-0"	-
B107	MENS ADA TOILET	LUX VINYL OR PLANK	VINYL	EXIST PLASTER & NEW PTD UR. GYP BD	PTD UR. GYP BD	9'-0"	-
B108	NURSERY	CARPET SQUARES		EXIST PLASTER & NEW PTD GYP BD	PTD EXPOSED STRUCTURE	EXISTING	-

VERIFY ALL FINISHES WITH OWNER - PATCH & REPAIR ALL EXIST AS REQ'D

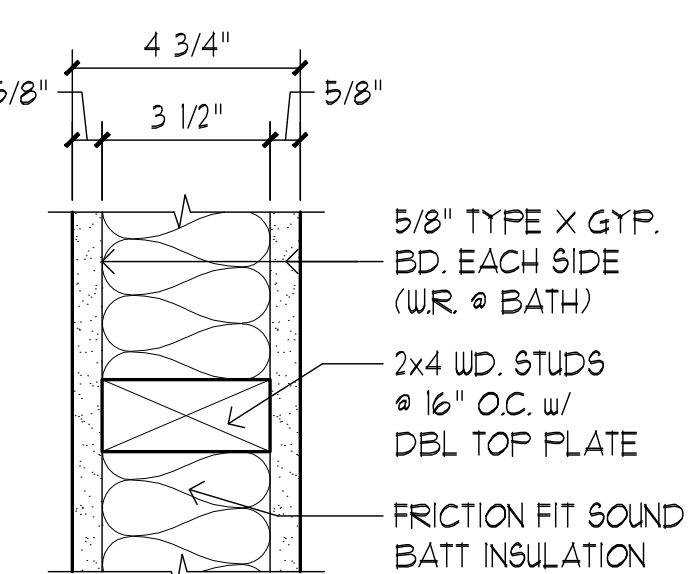


- A** INTERIOR WALL
- B** PLUMBING WALL
SIM w/ 6" WD STUDS
- C** WALL @ BOTTLE FILL
SIM w/ 8-10" WD STUDS

WALL TYPES

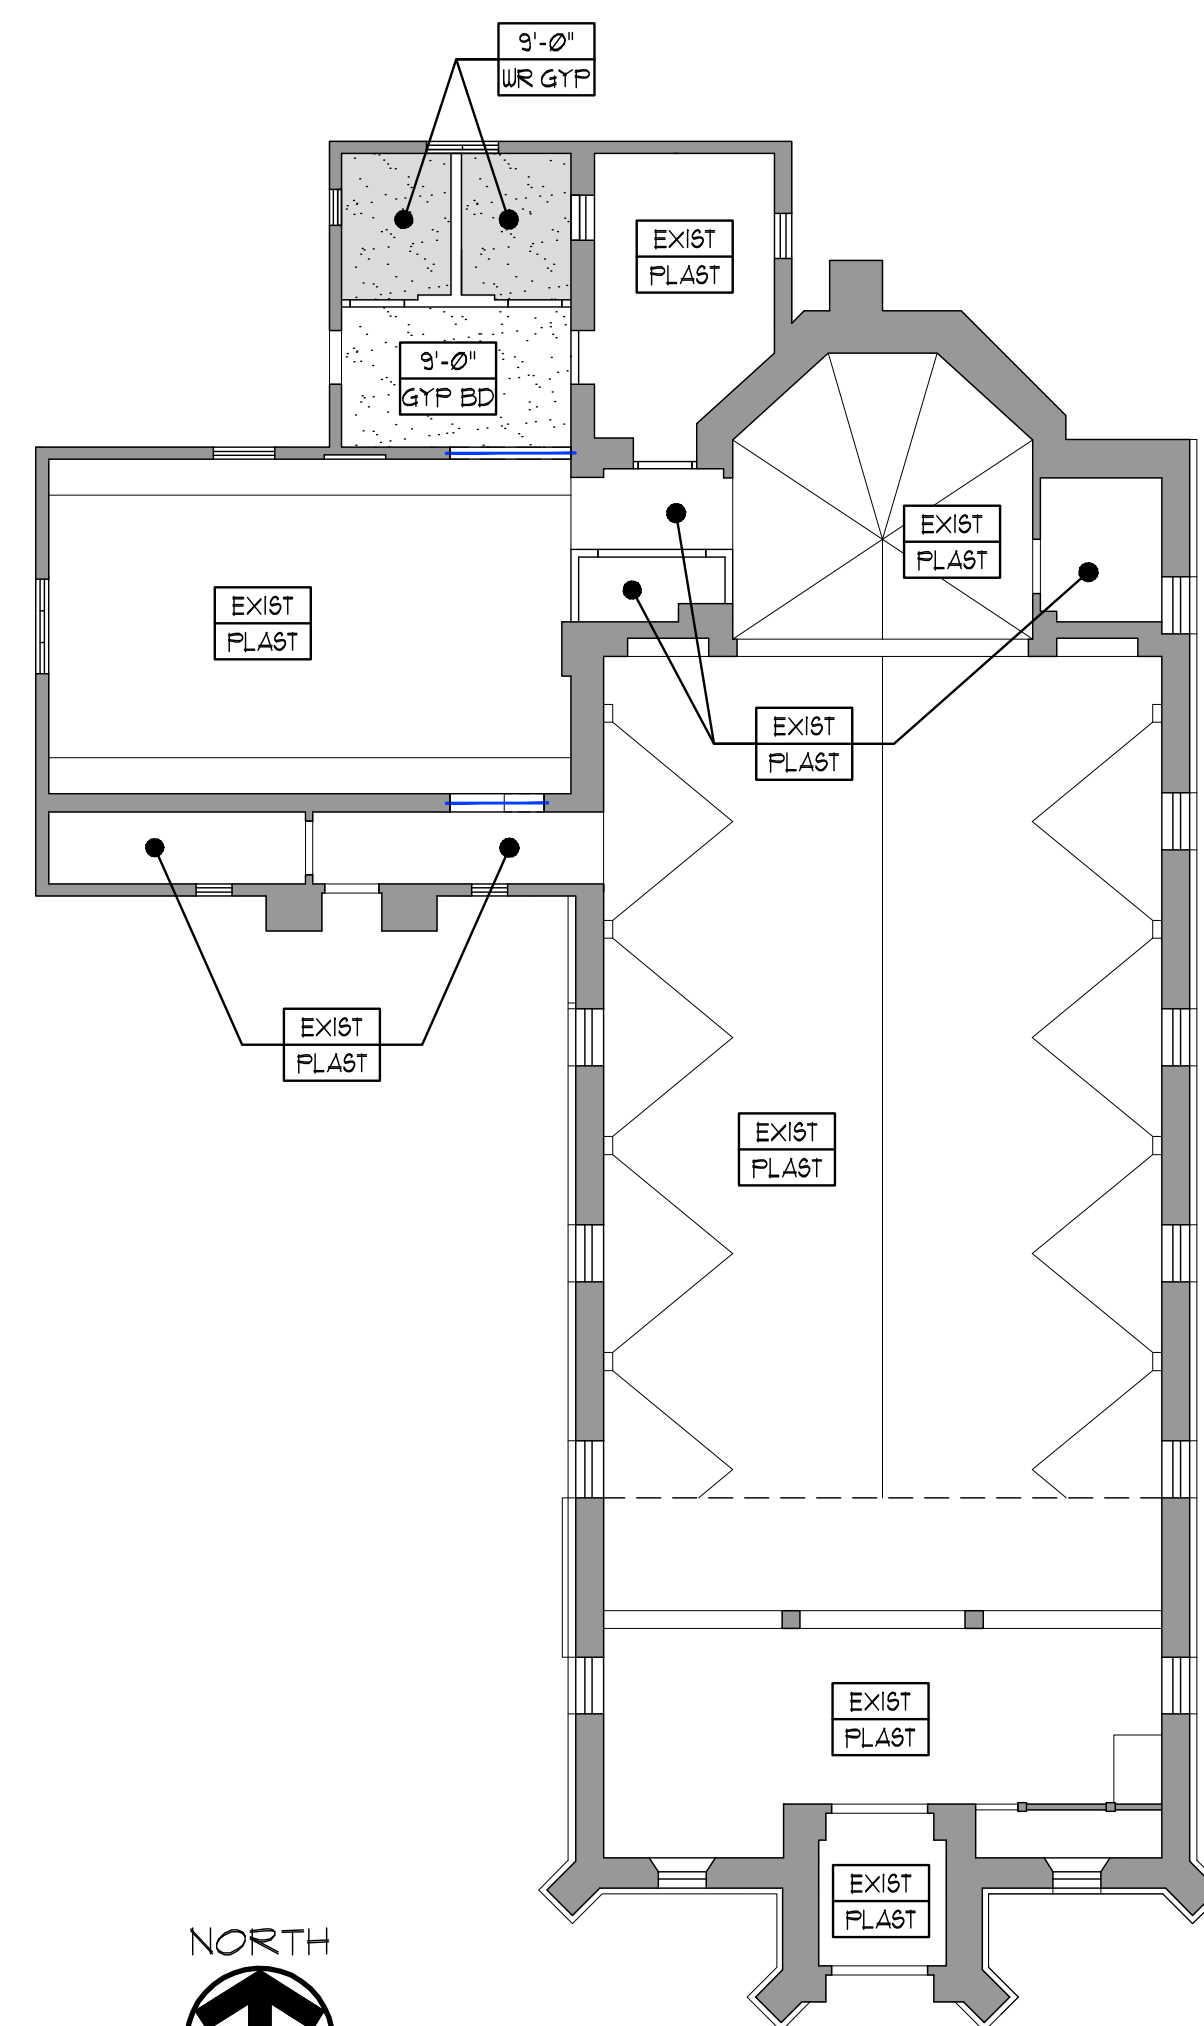

FIRST FLOOR RCP


3/32" = 1'-0"

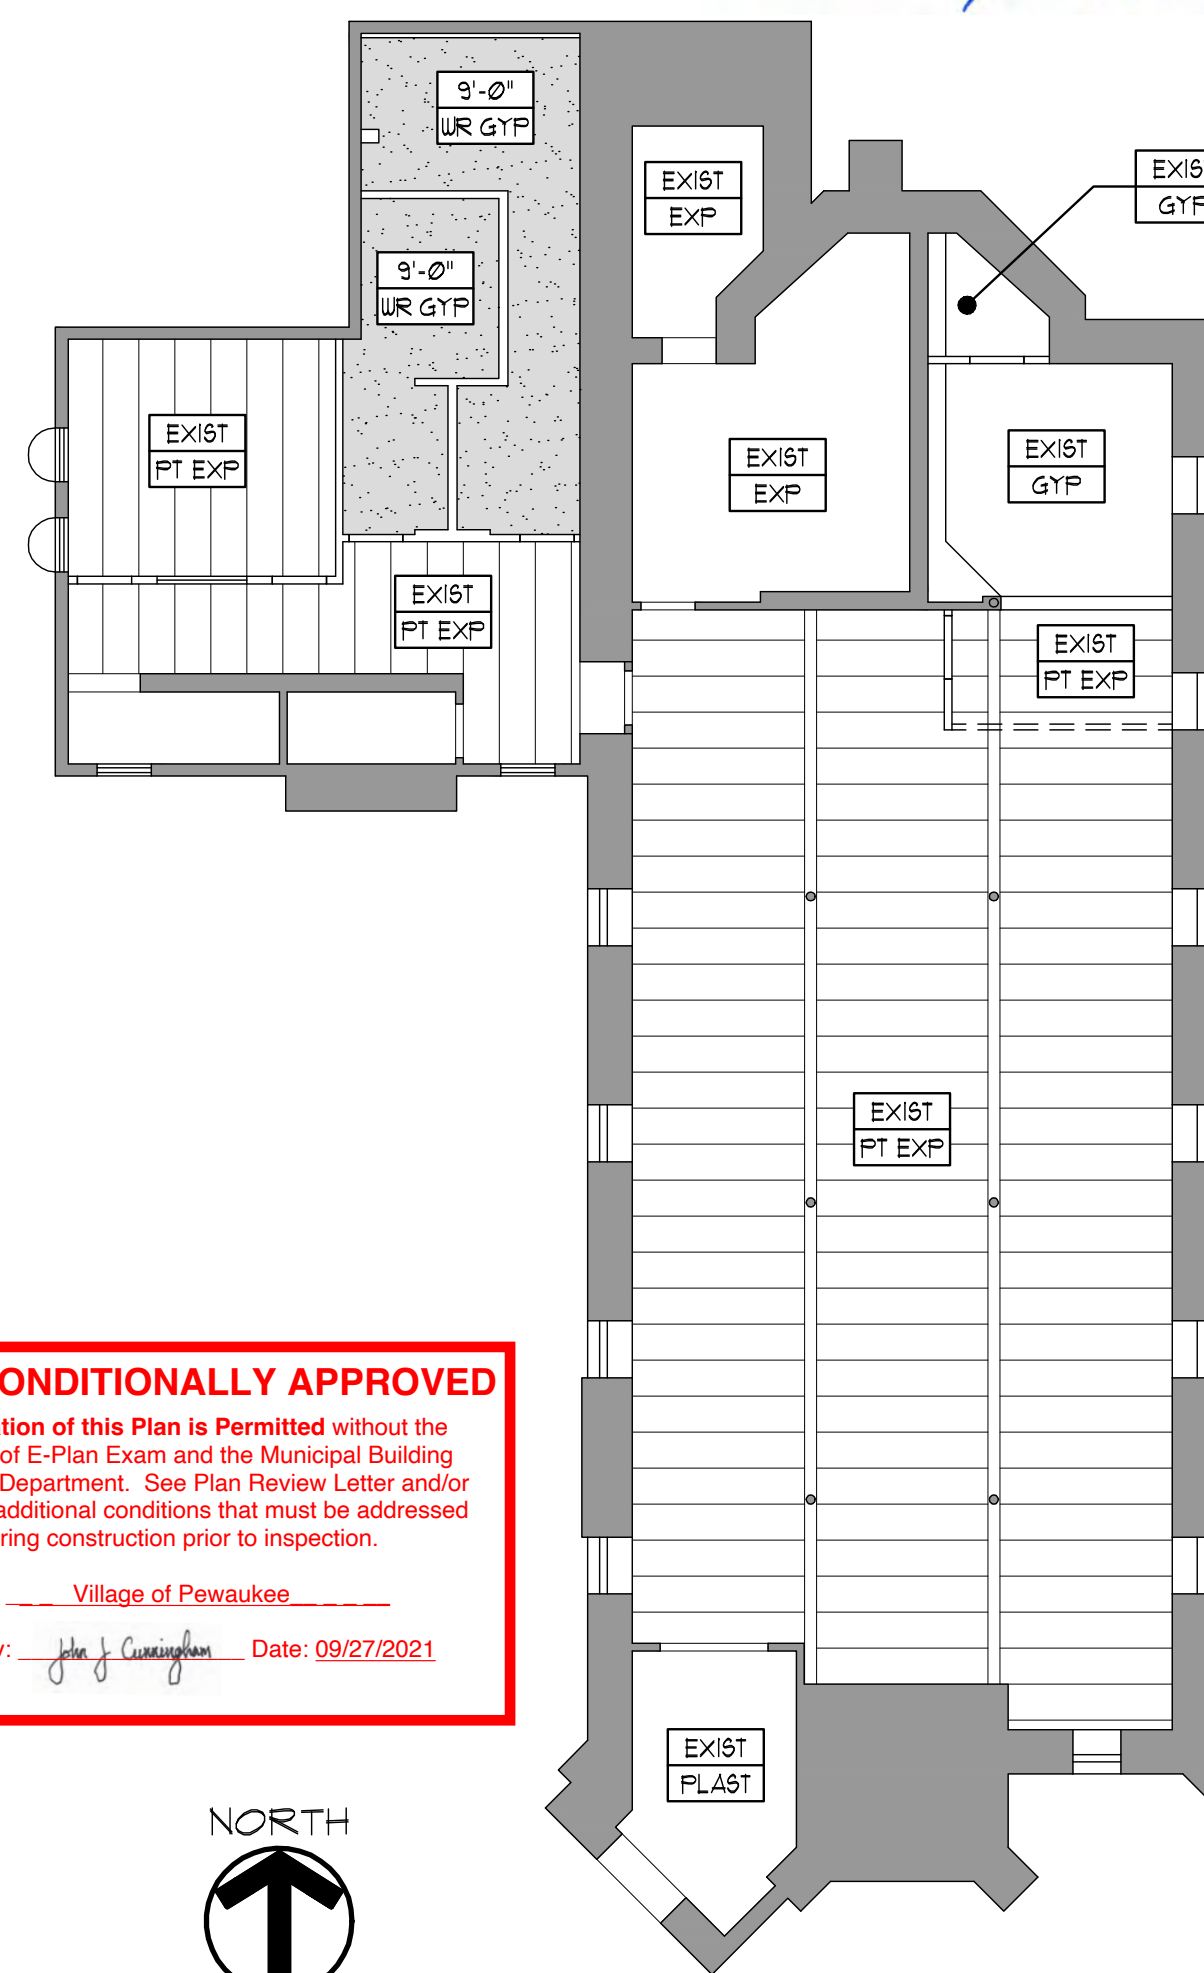


BASEMENT RCP

3/32" = 1'-0"

PLAN CONDITIONALLY APPROVED
No Variation of this Plan is Permitted without the Approval of E-Plan Exam and the Municipal Building Inspection Department. See Plan Review Letter and/or Permit for additional conditions that must be addressed during construction prior to inspection.
Municipality: Village of Pewaukee
Approved By: John J. Cunningham Date: 09/27/2021

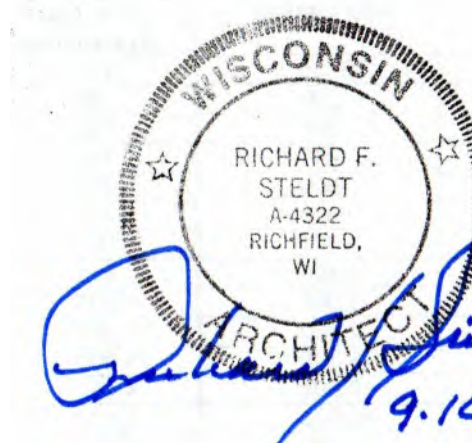

RICHARD F. STELDT & ASSOCIATES, LTD. ARCHITECTS
9502-4500
N90 W16890 ROOSEVELT DR. #B, MENOMONEE FALLS, WI 53051

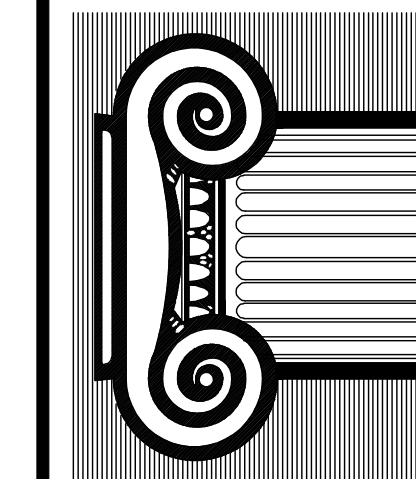

Drawn: AAP

Approved:

09-10-2021
REVISED FOR REVIEW

date comments

REVISIONS

Job: 2430-621

Date: 9-10-21

QUESTIONS OR COMMENTS
This document and the ideas and designs incorporated herein, are the property of Richard F. Steldt and Associates, Ltd. and is not to be used in whole or in part, for any other project without the written authorization of Richard F. Steldt and Associates, Ltd.

agape COMMUNITY CHURCH

Sheet

A-4